


T.5&6S. R.1W. W.M.

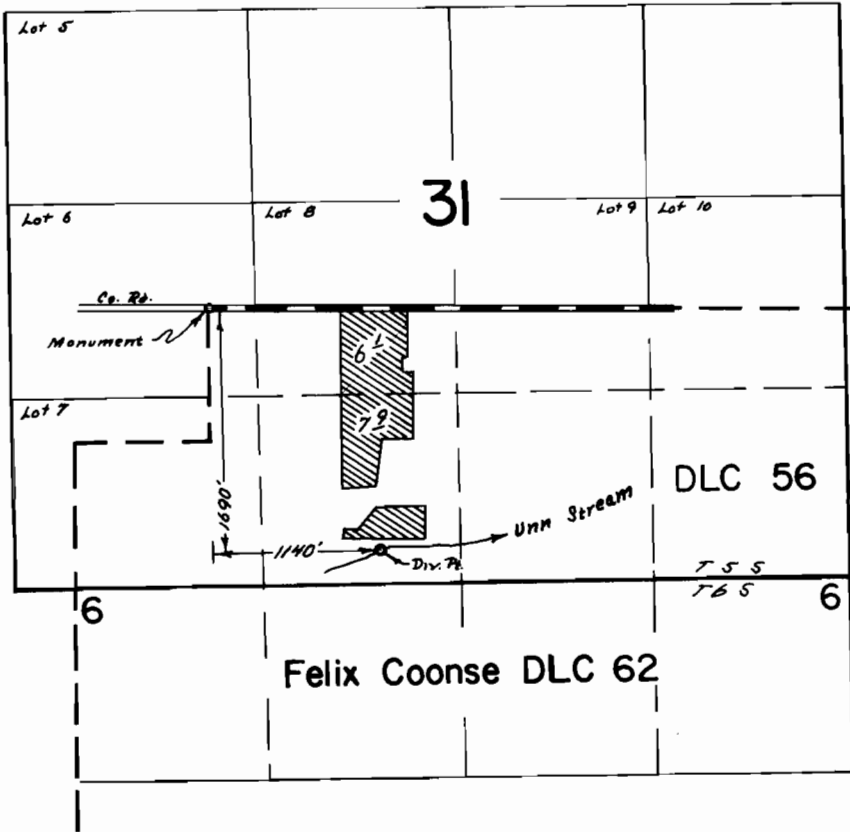

FINAL PROOF SURVEY UNDER

Application No. 45201 Permit No. 3376B
IN NAME OF

J. H. MESSER

Surveyed Aug. 18 1972, by R. G. Mucken