


T.9S.R.3E.W.M.

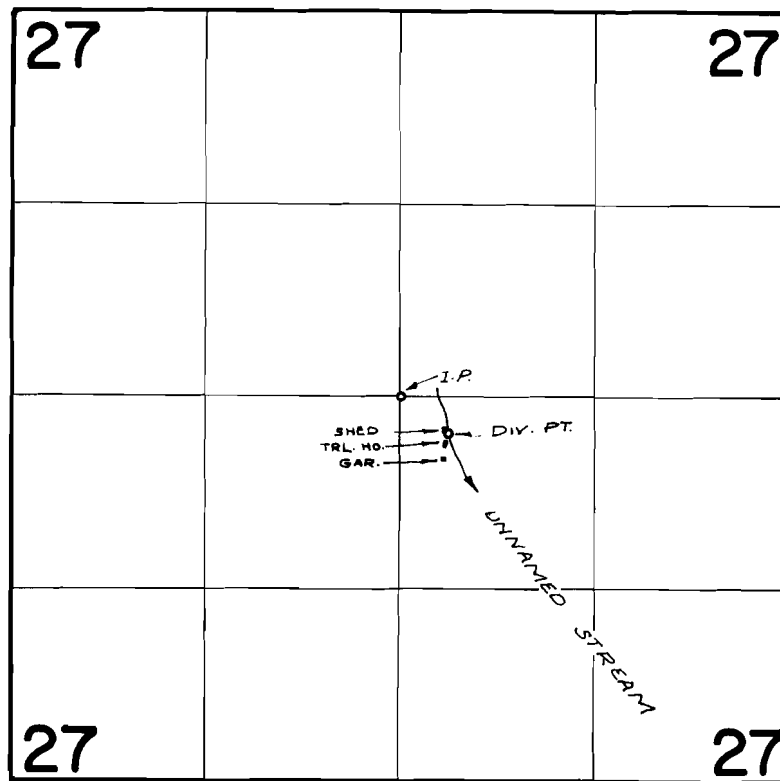

DIV. PT. LOC: 240'S. & 330'E. FROM CEN. SEC. 27

FINAL PROOF SURVEY
UNDER

Application No. 44010 Permit No. 34364
IN NAME OF

JOHN R. PARR

Surveyed JULY 25, 1972, by R. MUCKEN