


T.6S. R.2W. W.M.

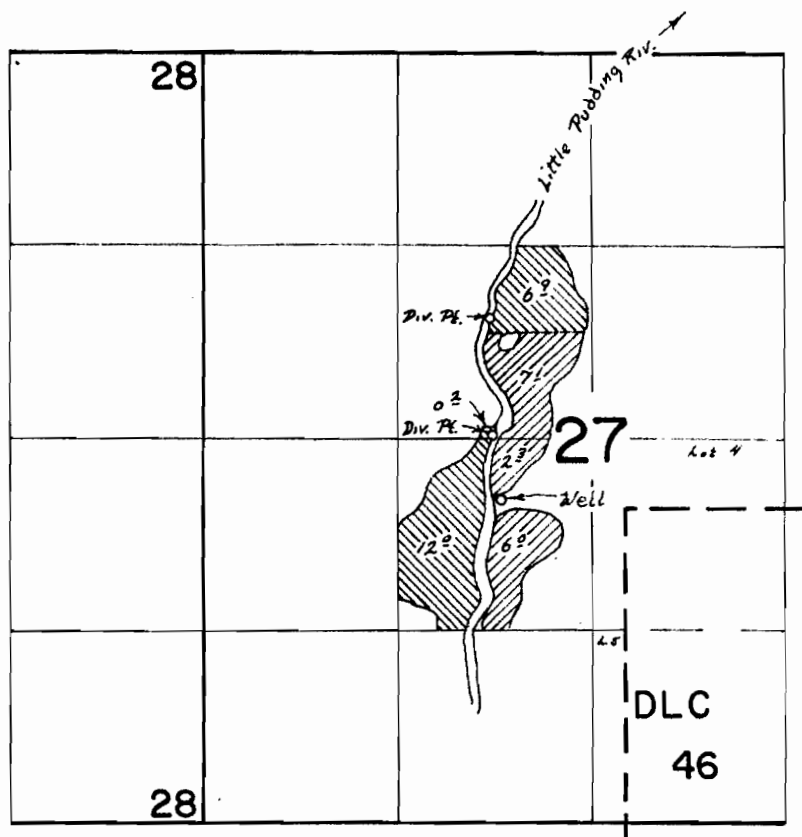

Div. Pt. Loc: 2150' N & 620' E ; Div. Pt. Loc: 1340' N & 650' E ; Well
Loc: 900' N & 770' E ; ALL From SW Cor NE 1/4 SW 1/4 Sec. 27

FINAL PROOF SURVEY UNDER

Application No. 6-4771 44960 Permit No. 6-4494 33199
IN NAME OF

ERVIN KASPER

Surveyed April 28 1972, by R. G. Musken

