


T. 7S.R.1W. W.M.

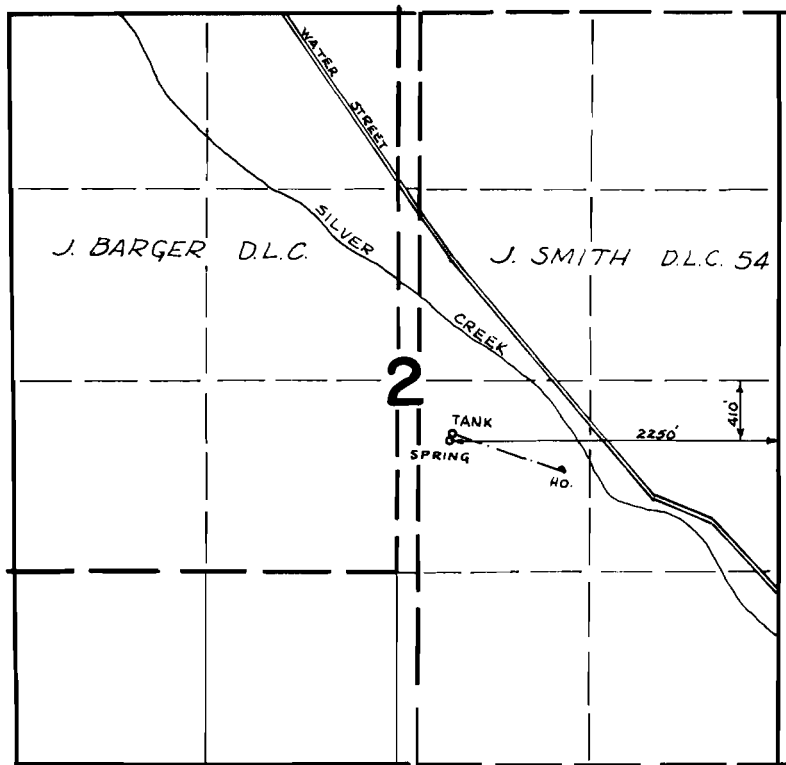

FINAL PROOF SURVEY UNDER

Application No. 45005 Permit No. 33329
IN NAME OF

WILLIAM F. & MARIE MAXWELL

Surveyed APRIL 20 1972, by D. NORBY