


# T.6S. R.28&3W. W.M.

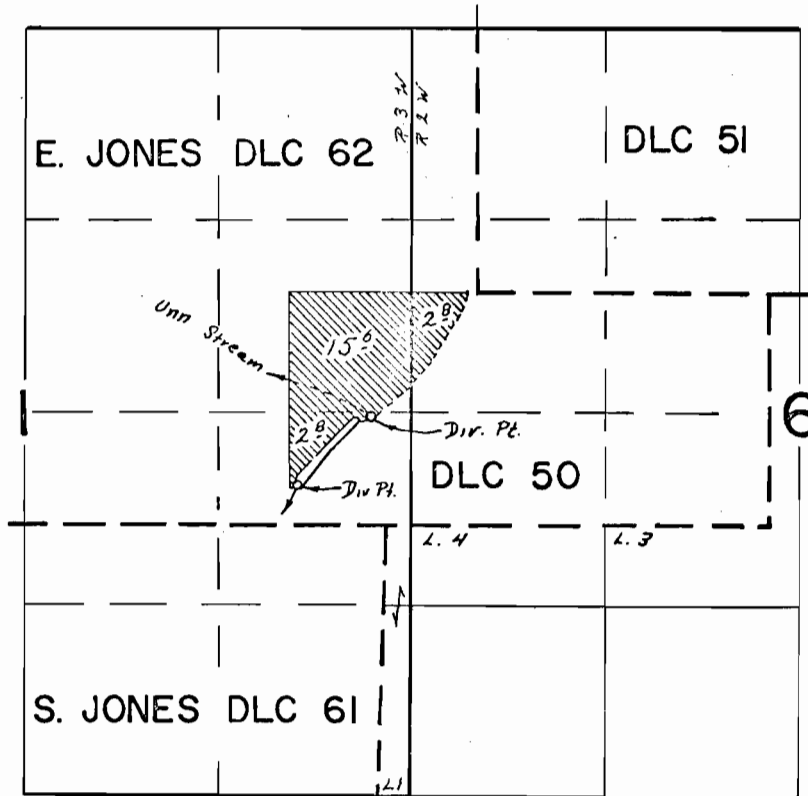

Res. Loc. 270' N & 600' W Unn Str. Div. Loc. 750' N & 100' W Both  
From NE Cor. S. Jones DLC "61"

## FINAL PROOF SURVEY UNDER

Application No. R-43257 ~~42258~~ Permit No. R-4939 ~~32275~~  
IN NAME OF

TED V. BELL

Surveyed Nov. 3 1972, by R. E. Mucken