


T.G.S., R.I.E., W.M.

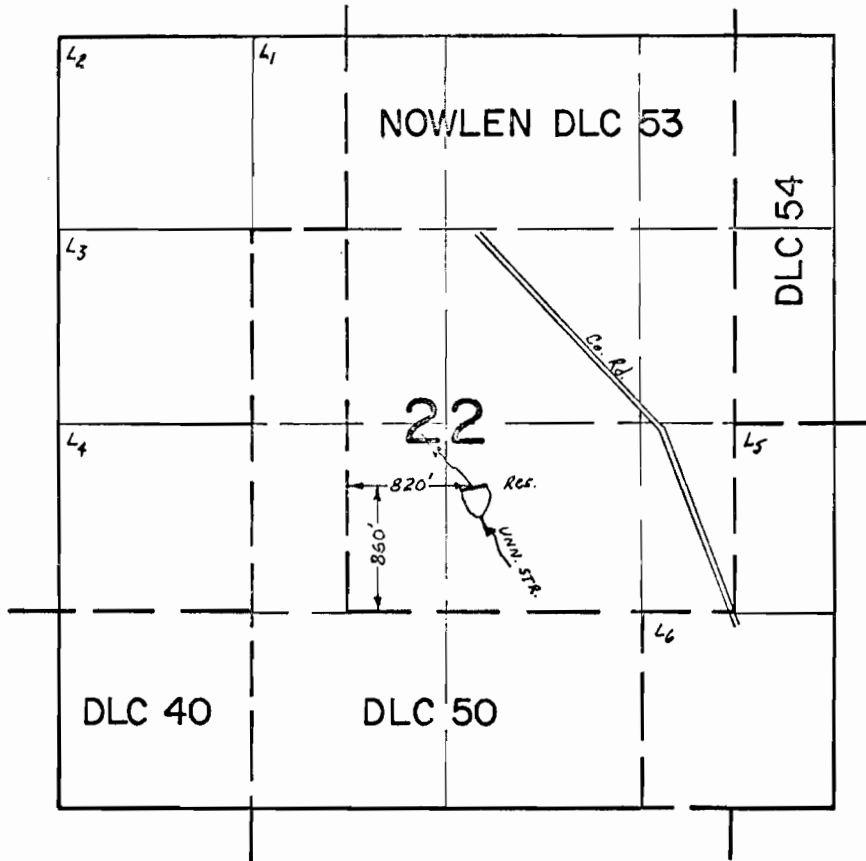

FINAL PROOF SURVEY UNDER

R-44348 R-5068
Application No. 44349 Permit No. 32868.....
IN NAME OF

E. D. KINNEY

Surveyed Oct. 13, 1972, by R.G. Mucken