


T. 7S. R. 1W. W.M.

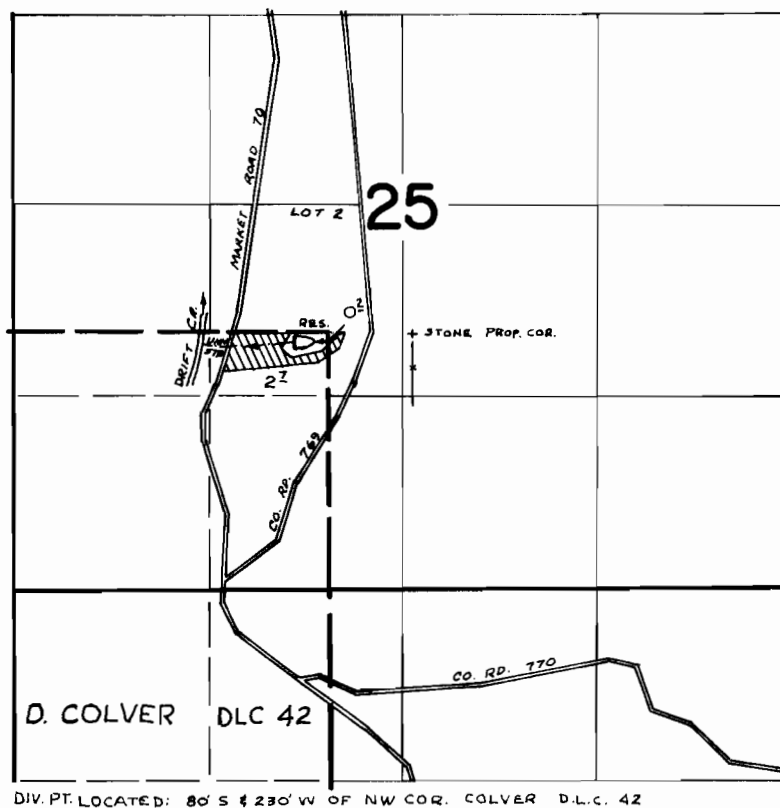

FINAL PROOF SURVEY

UNDER

Application No. 45349 ^{R-45348} Permit No. 33861 ^{R-5359}
IN NAME OF

ARTHUR QUALEY

Surveyed APRIL 21 1972, by D. NORBY