


T. 7S. R. 1W. W.M.

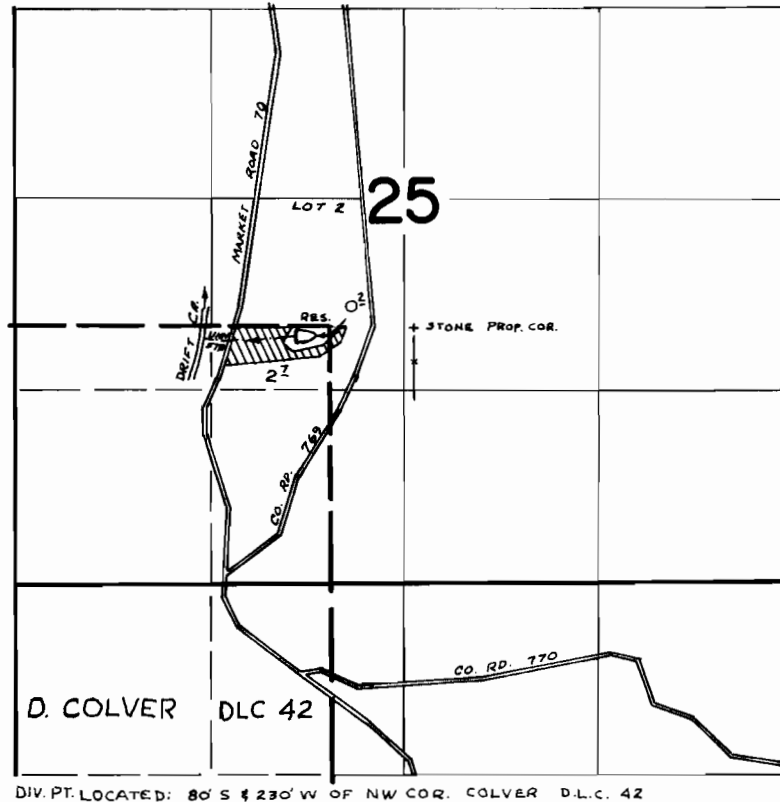

FINAL PROOF SURVEY
UNDER

Application No. R-45348 45349 Permit No. R-5359 33861
IN NAME OF

ARTHUR QUALEY

Surveyed APRIL 21 1972, by D. NORBY