


T.7S. R.1E. W.M.

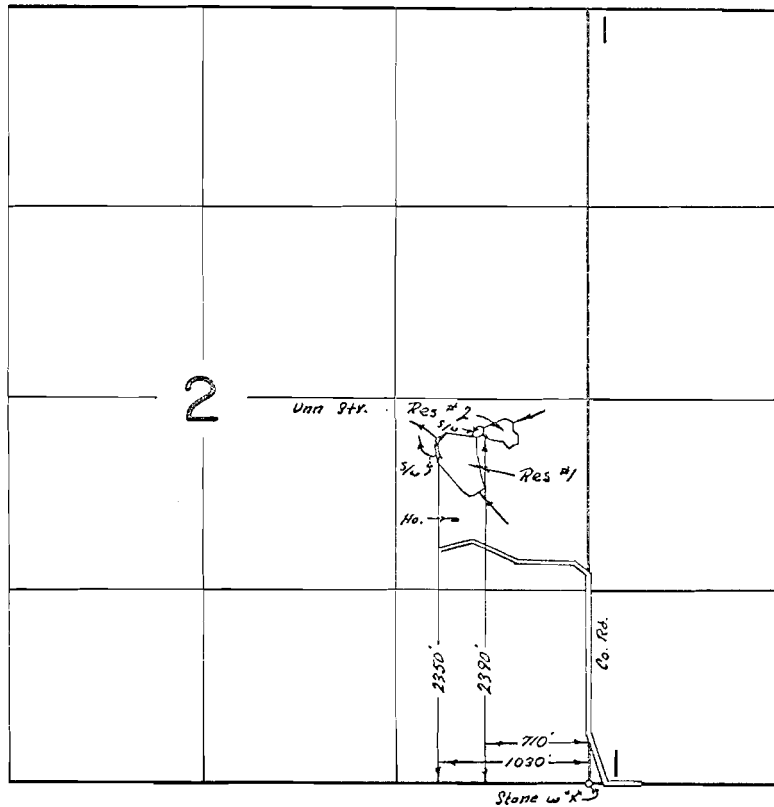

FINAL PROOF SURVEY
UNDER

48727
R-48726
45927

36552
R-5911
34014

Application No. R-45926 Permit No. R-5389
IN NAME OF

CHARLES DEVERS

Surveyed July 5 1977, by R.G. Mucken