


T.7S. R.1E. W.M.

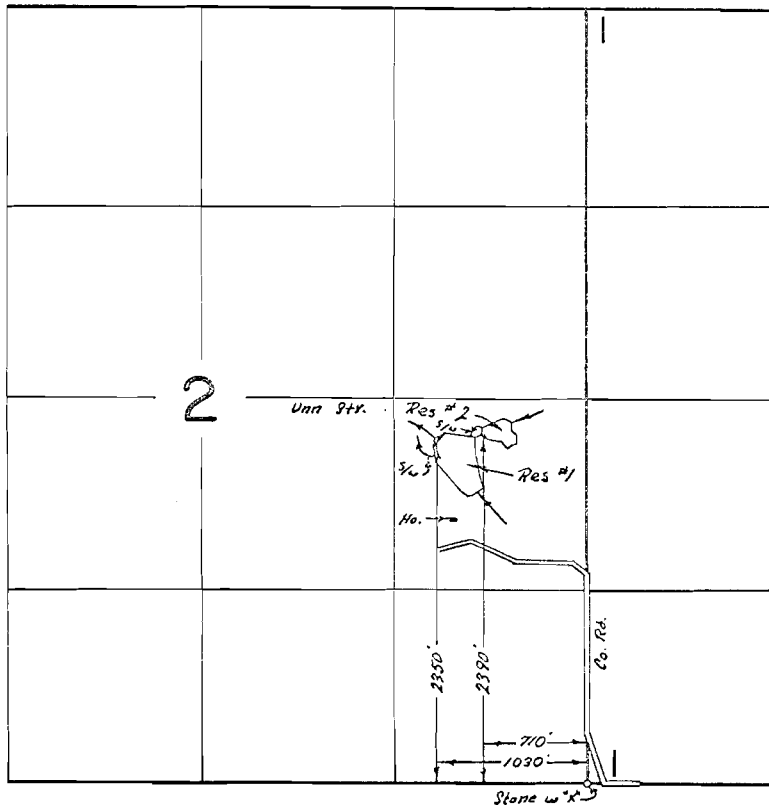

FINAL PROOF SURVEY
UNDER

48727

36552

R-48726

R-5911

45927

34014

Application No. R-45926 Permit No. R-5389

IN NAME OF

CHARLES DEVERS

Surveyed July 5 1977 by R.G. Mucken