


T.6S. R.6W. W.M.

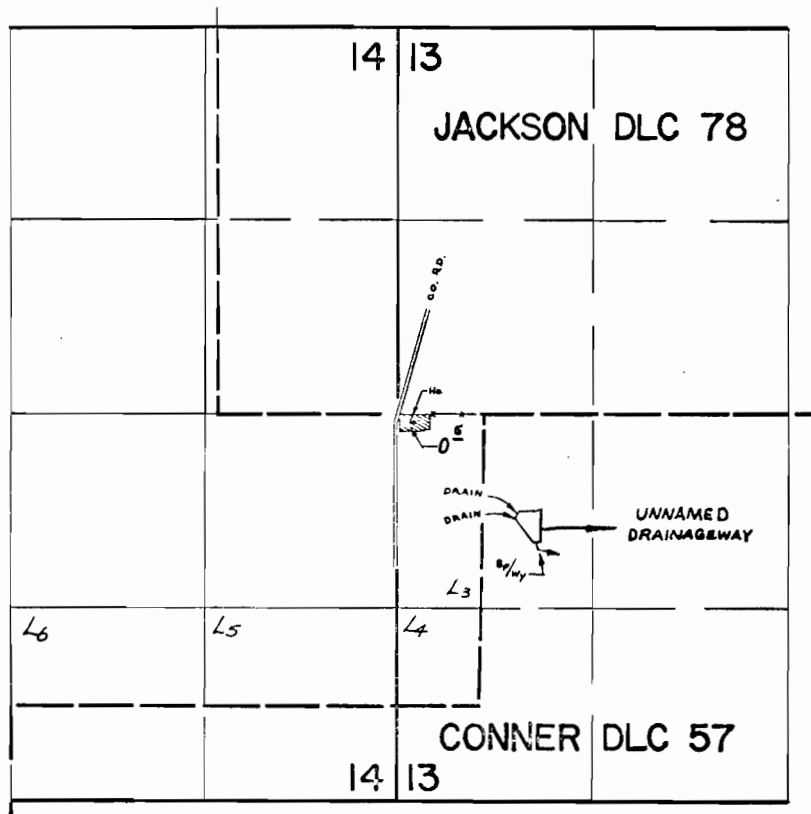

Div. Pt. Loc. 780' S. & 970' E. from W. $\frac{1}{4}$ Cor. Sec. 13

FINAL PROOF SURVEY
UNDER

Application No. 46308 Permit No. 34586
R-46307 R-5511
IN NAME OF

REED NEUSCHWANGER

Surveyed MAY 26, 1972, by L. E. GOULD
Surveyed MAY 30, 1973, by R. G. MUCKEN