


T.6S. R.6W. W.M.

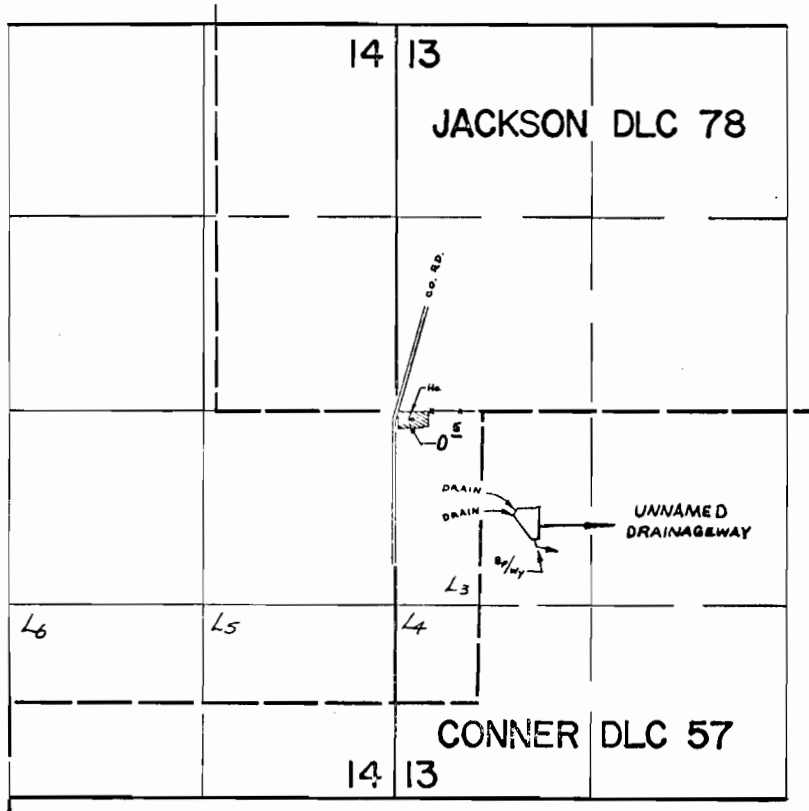

Div. Pt. Loc.: 780' S. & 970' E. From W. $\frac{1}{4}$ Cor. Sec. 13

FINAL PROOF SURVEY UNDER

Application No. 46308 Permit No. 34586
R-46307 R-5511
 IN NAME OF

REED NEUSCHWANGER

Surveyed MAY 26, 1972, by L. E. GOULD
 Surveyed MAY 30, 1973, by R. G. MUCKEN