


T. 1 N. R. 39 E. W.M.

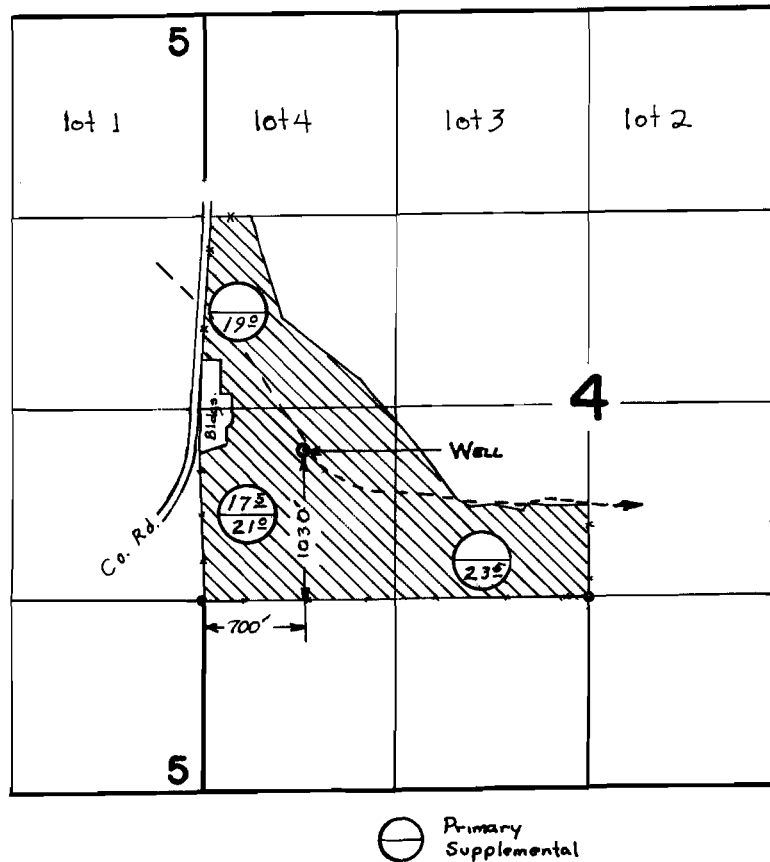

FINAL PROOF SURVEY
UNDER

Application No. G 2759 Permit No. G 2564
IN NAME OF

EDWARD G. & VERA M. THOMPSON

Surveyed 21 JULY 1969, by L. E. Gould
W. J. RUPPERT