


T.2S.,R.44E.,W.M.

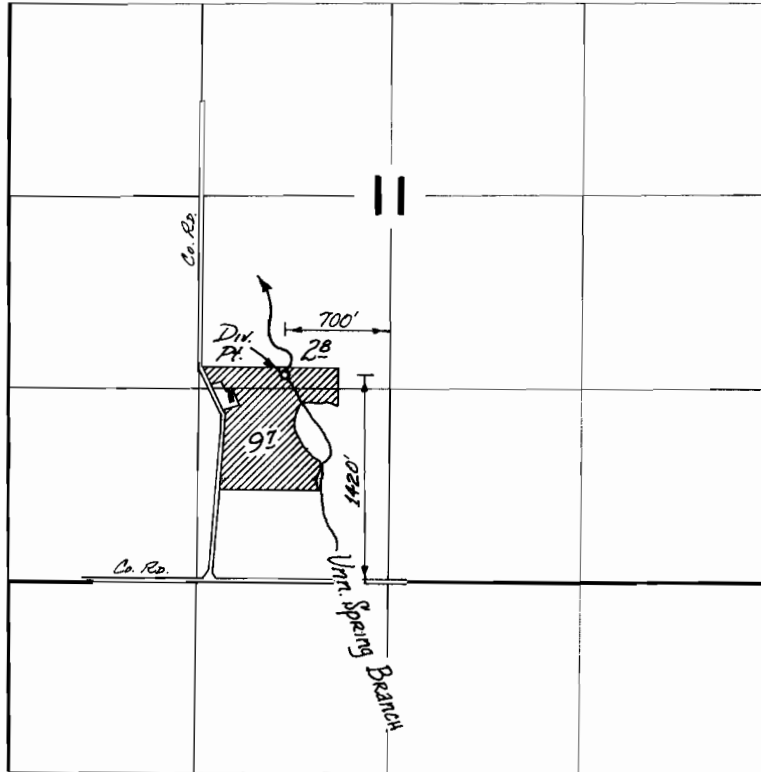

**FINAL PROOF SURVEY**  
UNDER

Application No. 46223 Permit No. 34535  
IN NAME OF

JAMES O. & DONA C. ELLIOTT

Surveyed Aug. 7 1973, by D. NORBY