


THOS, R.W., W.M.

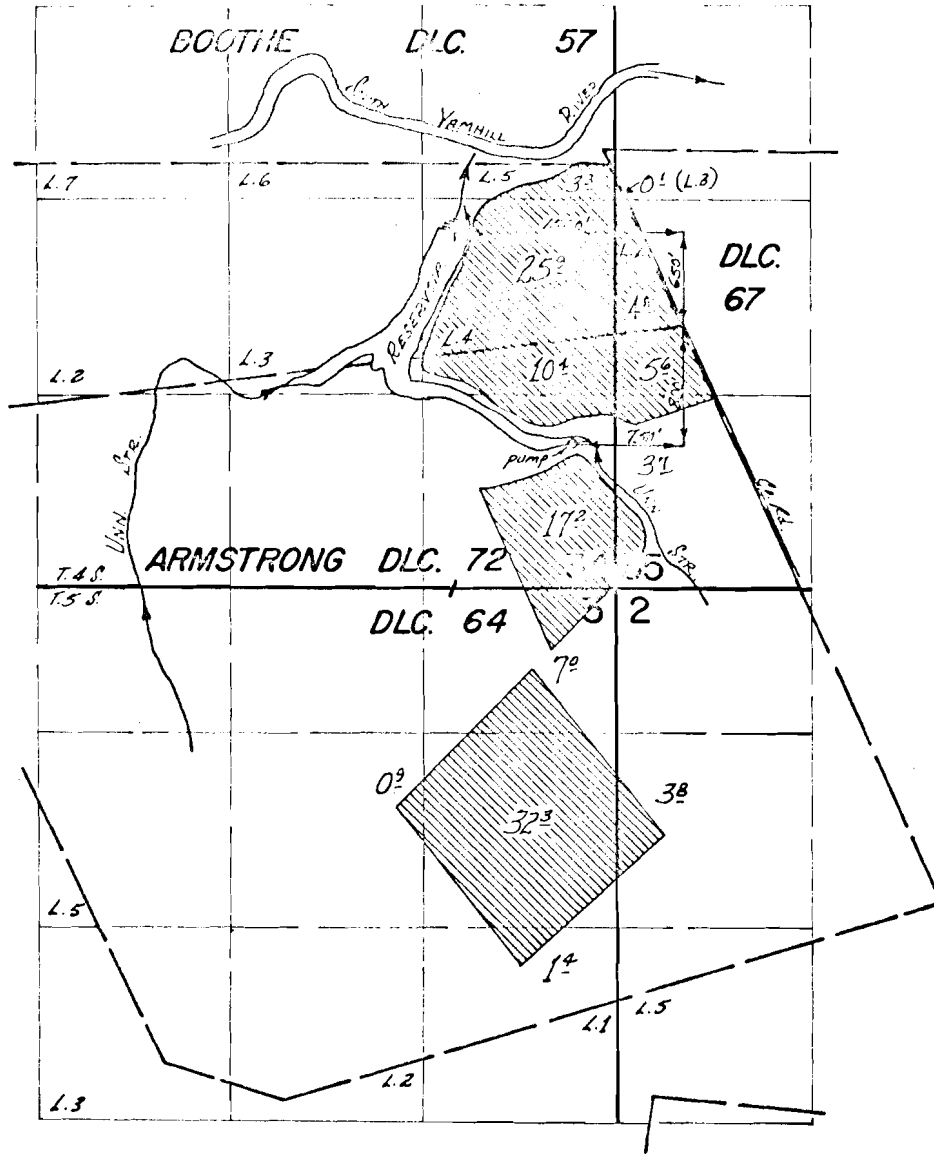

FINAL PROOF SURVEY
UNDER

R-41773 R-4694
Application No. 41774 Permit No. 31104
IN NAME OF

RAYMOND C. KAUER

Surveyed May 16 1973, by D. NORBY