T.4&5S., R.4W., W.M.

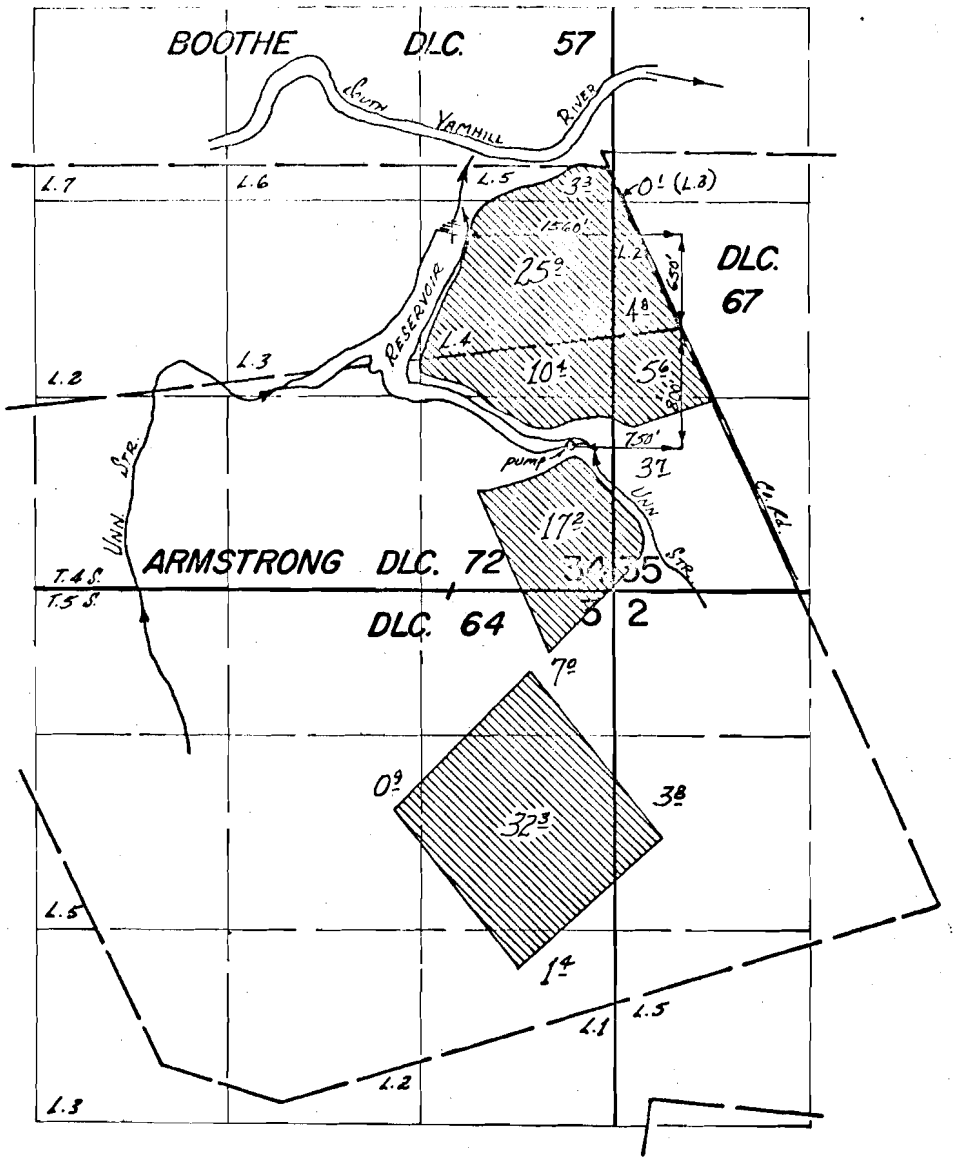

FINAL PROOF SURVEY

UNDER

R-41773 R-4694

Application No. 41774 Permit No. 31104

IN NAME OF

RAYMOND C. KAUER

Surveyed May 16 1973, by D. Norby

DPR-ILL-161 f 163