


T. 4 & 5 S., R. 4 W., W.M.

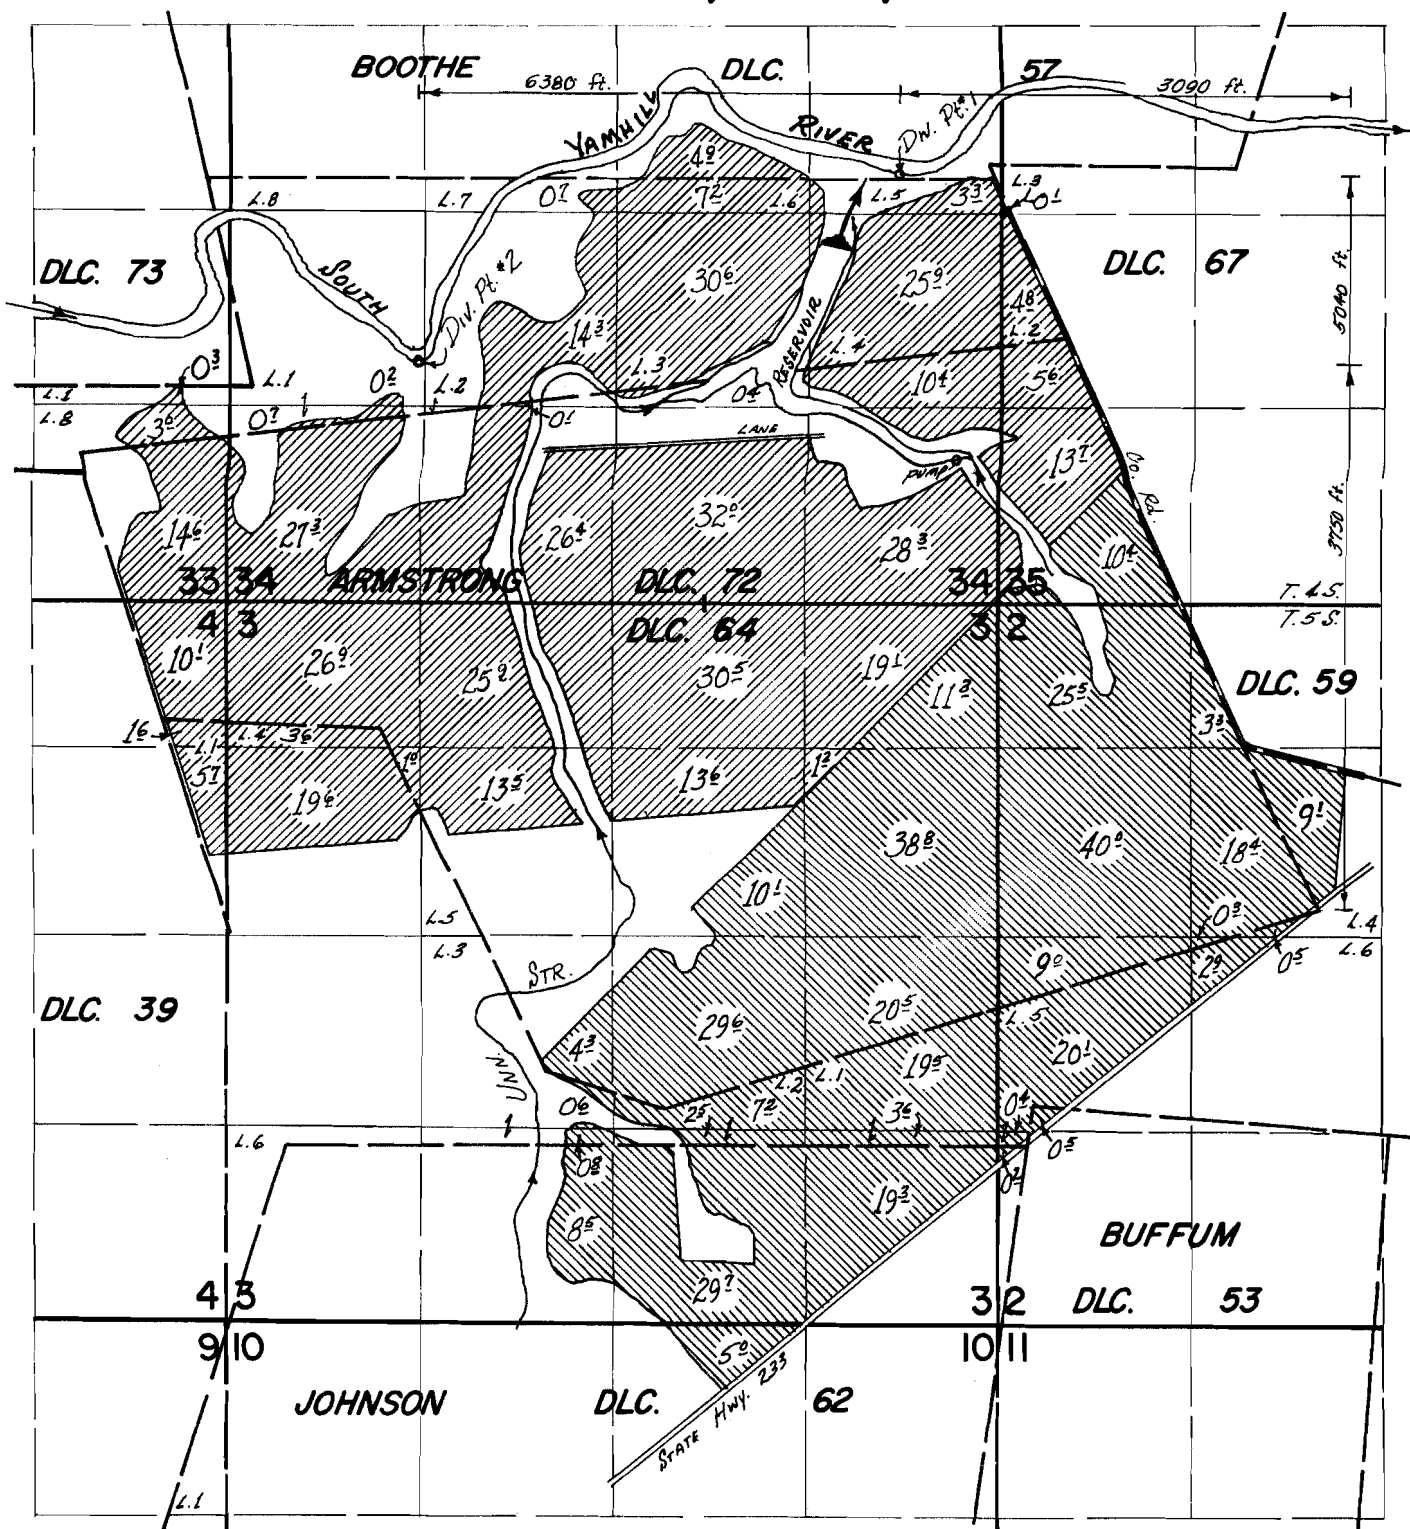

FINAL PROOF SURVEY

UNDER

Application No. 40809 Permit No. 30405
39565 29408



IN NAME OF

RAYMOND C. KAUER

Surveyed MAY 16 1973, by D. Noisy