


T. 4 & 5 S., R. 4 W., W.M.

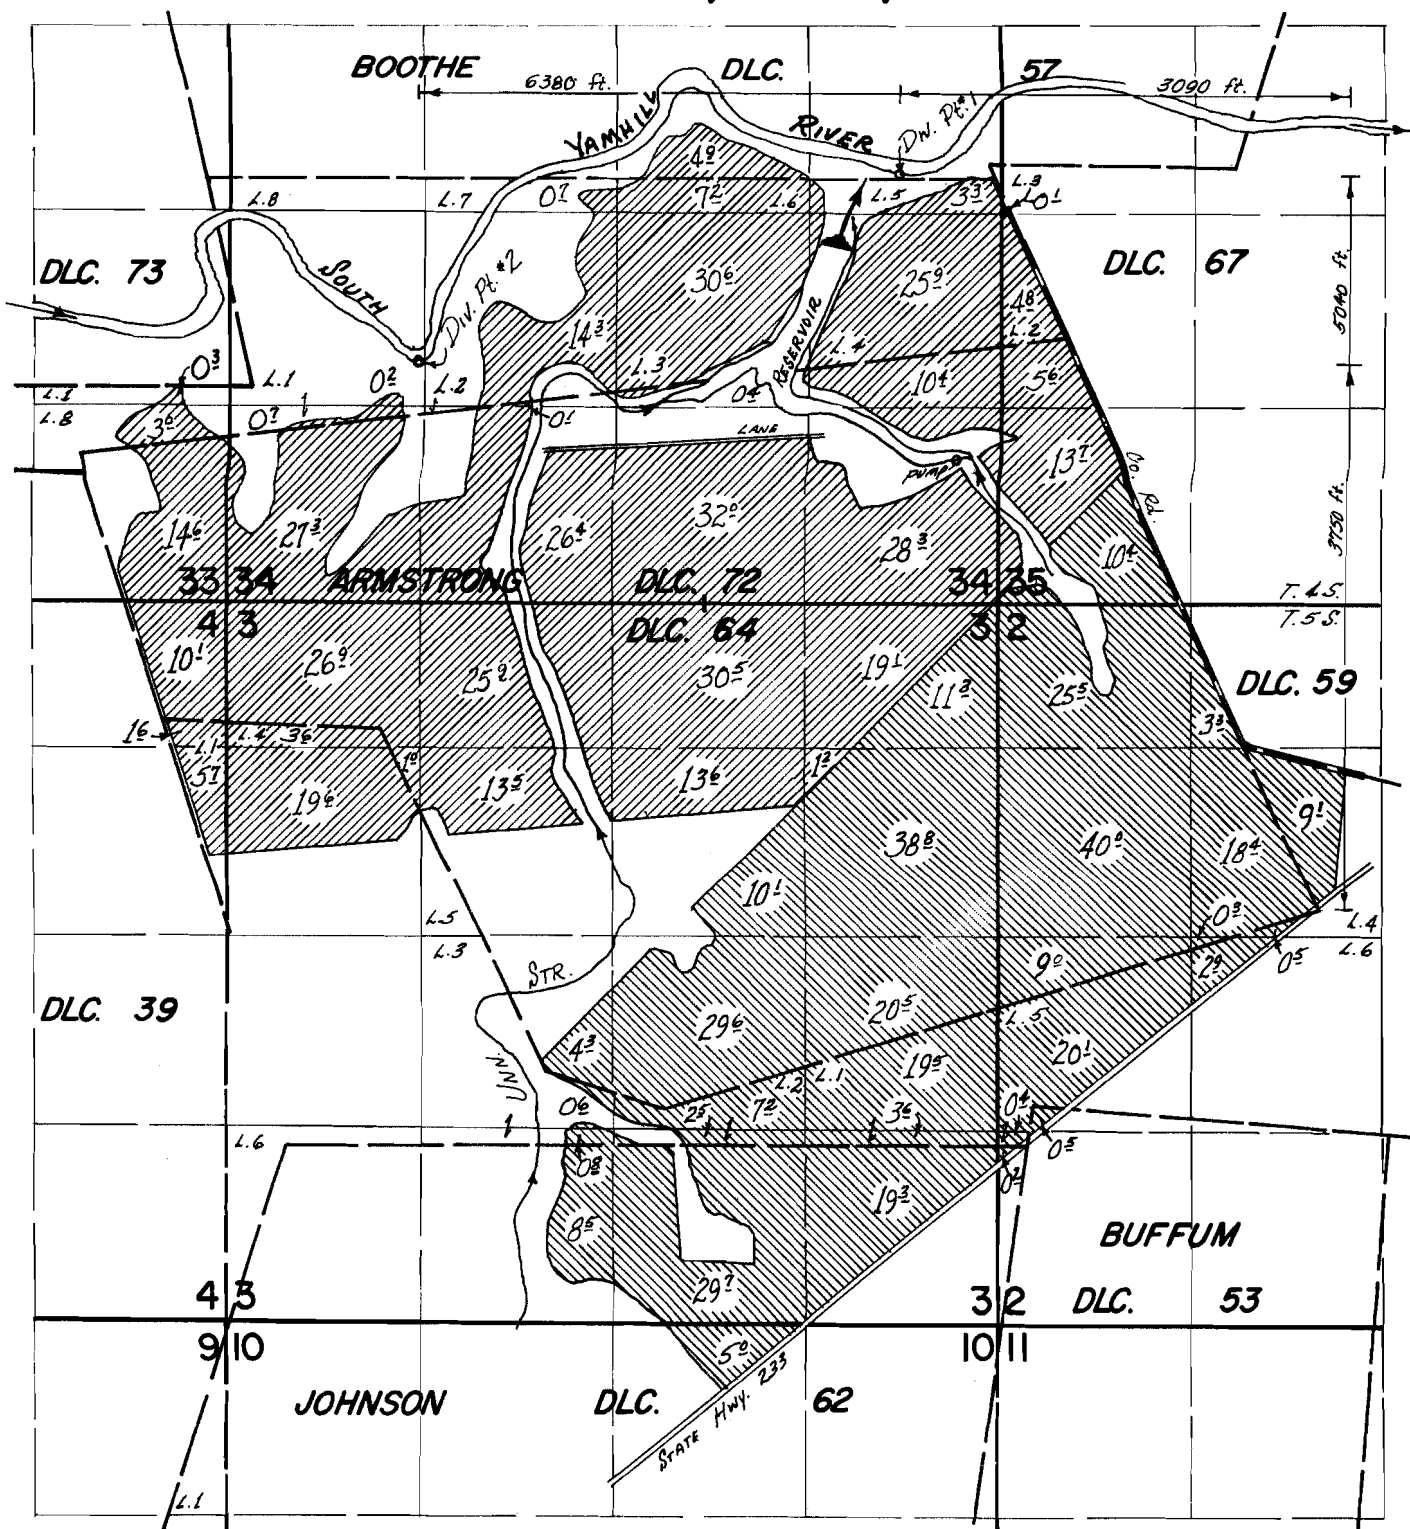

### FINAL PROOF SURVEY

UNDER

Application No. ~~40809~~ 39565 Permit No. ~~30405~~ 29408



IN NAME OF

RAYMOND C. KAUER

Surveyed May 16 1973, by D. Noeby