


T.4 S. R.3W. W.M.

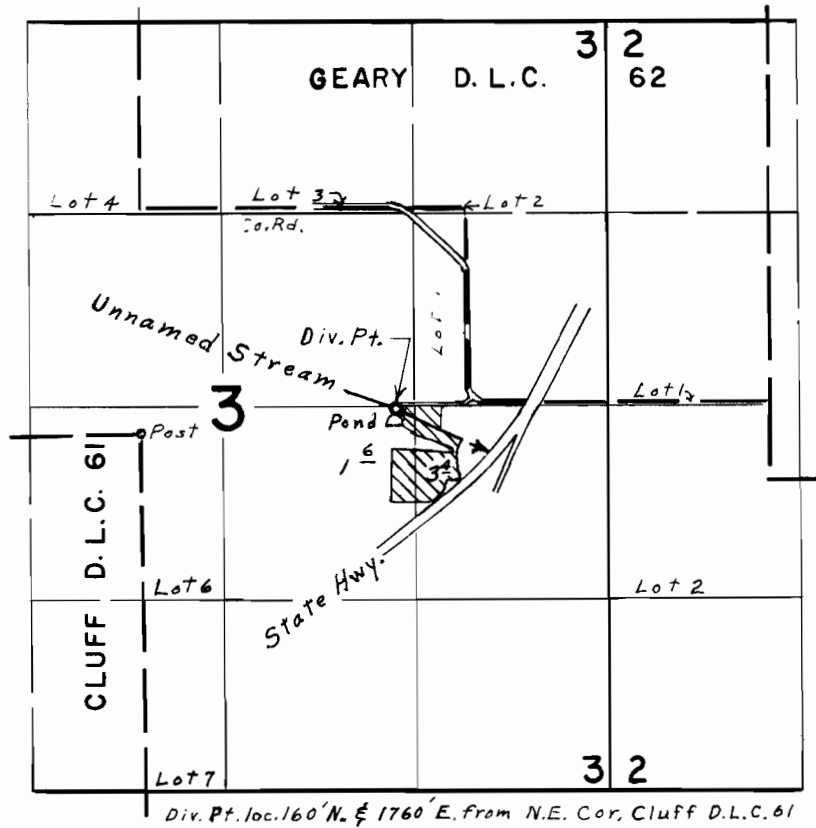

FINAL PROOF SURVEY UNDER

Application No. 42283 Permit No. 3162.2
 IN NAME OF
ESTATE OF ALFRED E. DIXON

Surveyed March 15, 1973 by L. E. Gould