


T.6S., R.3W., W.M.

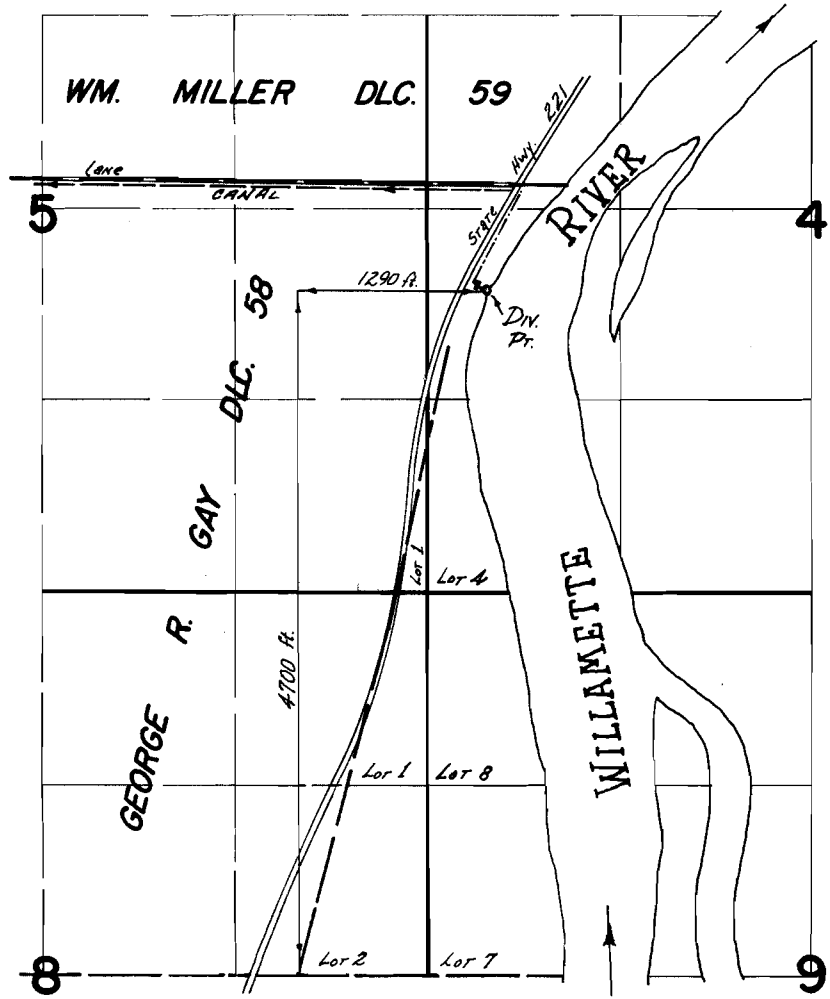


FINAL PROOF SURVEY
UNDER

Application No. 48355 Permit No. 35336
IN NAME OF

PETER N. EDIGER

Surveyed Sept. 6 1973, by L. E. Gault

T. 5 S., R. 3 W., W.M.

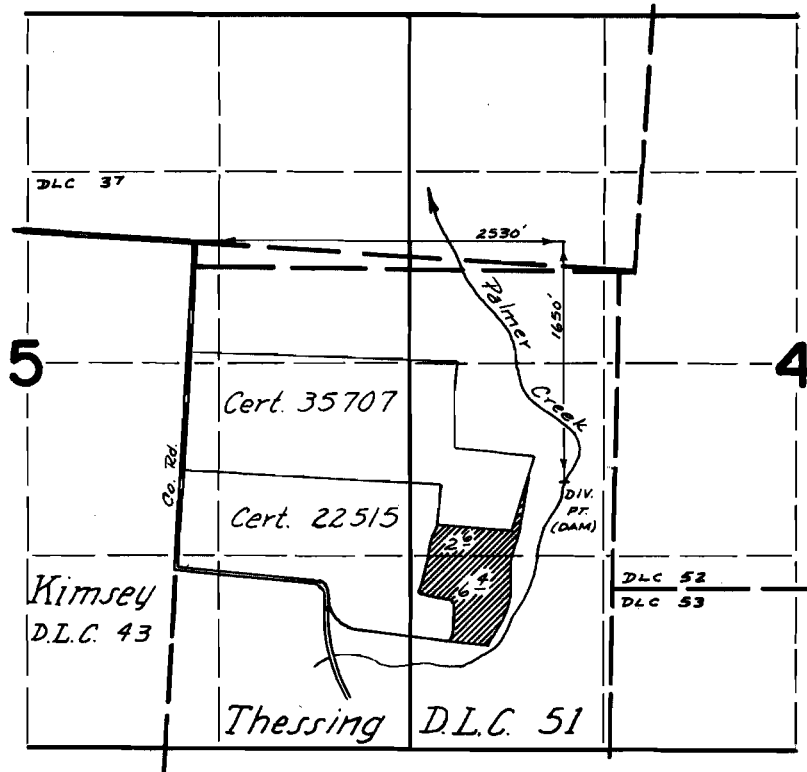

FINAL PROOF SURVEY UNDER

Application No. 48355 Permit No. 35336
IN NAME OF

PETER N. EDIGER

Surveyed May 19 1972, by D. Norby