


T.13S., R.6W., W.M.

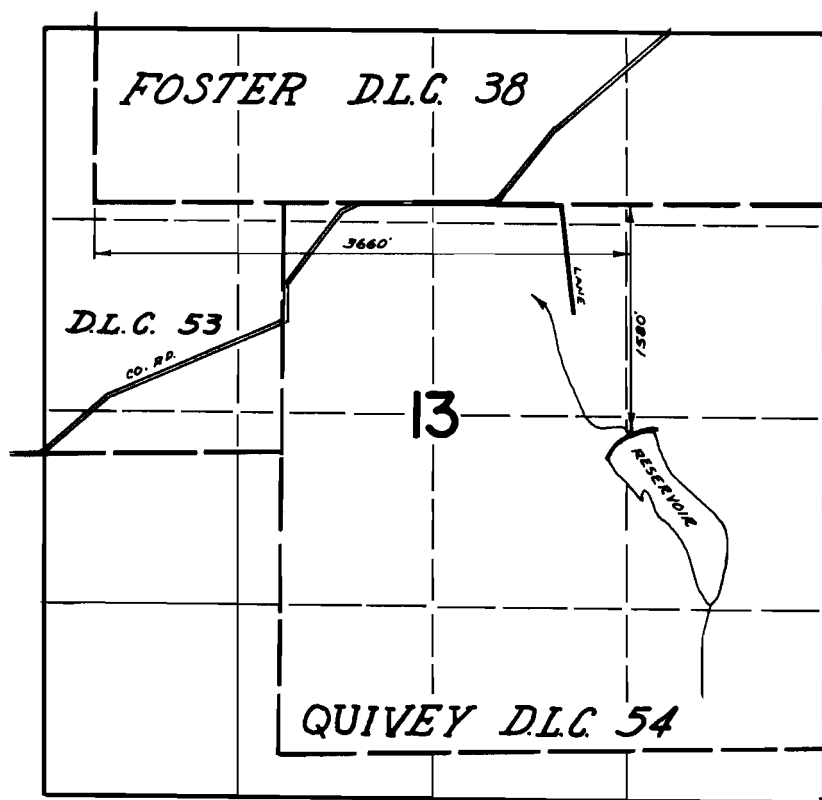

FINAL PROOF SURVEY
UNDER

Application No. R-46141 46174 Permit No. R-5415 34109
IN NAME OF

P. M. DE LAUBENFELS

Surveyed APRIL 2 19 73, by D. NORBY