


T. 30 S., R. 5 W., W.M.

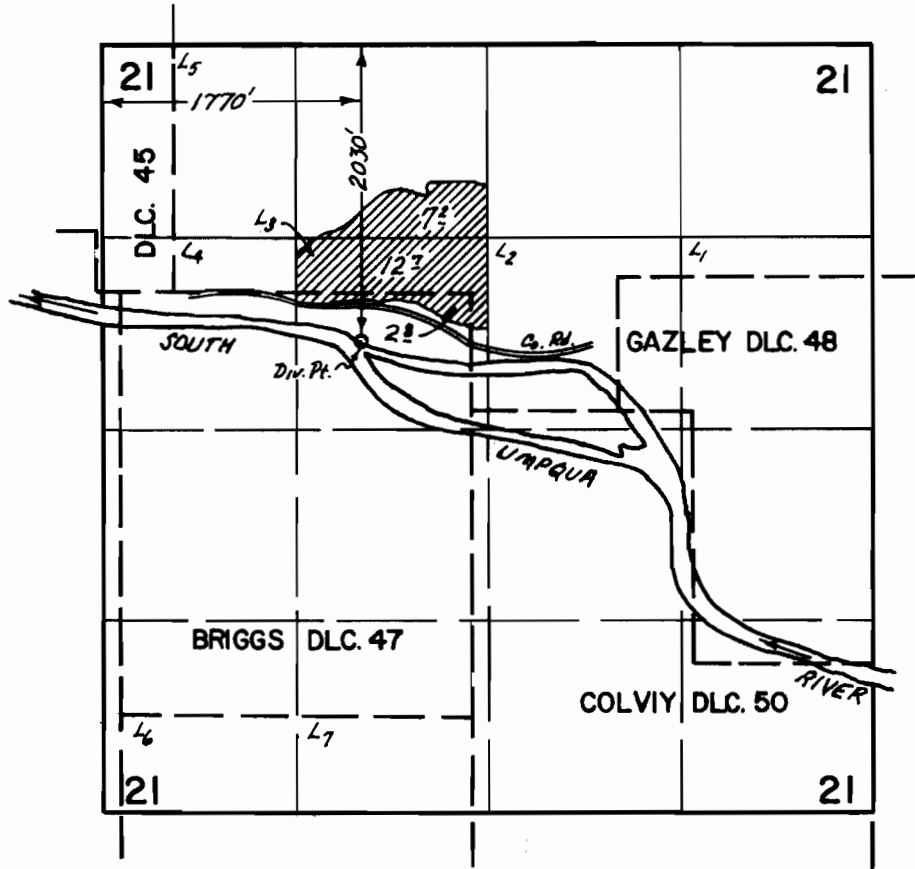

FINAL PROOF SURVEY
UNDER

Application No. 13473 Permit No. 32152
IN NAME OF

WILLIAM S. HILLMAN

Surveyed Sept. 14 1972, by D. NORBY