


T.29S., R.8 W., W.M.

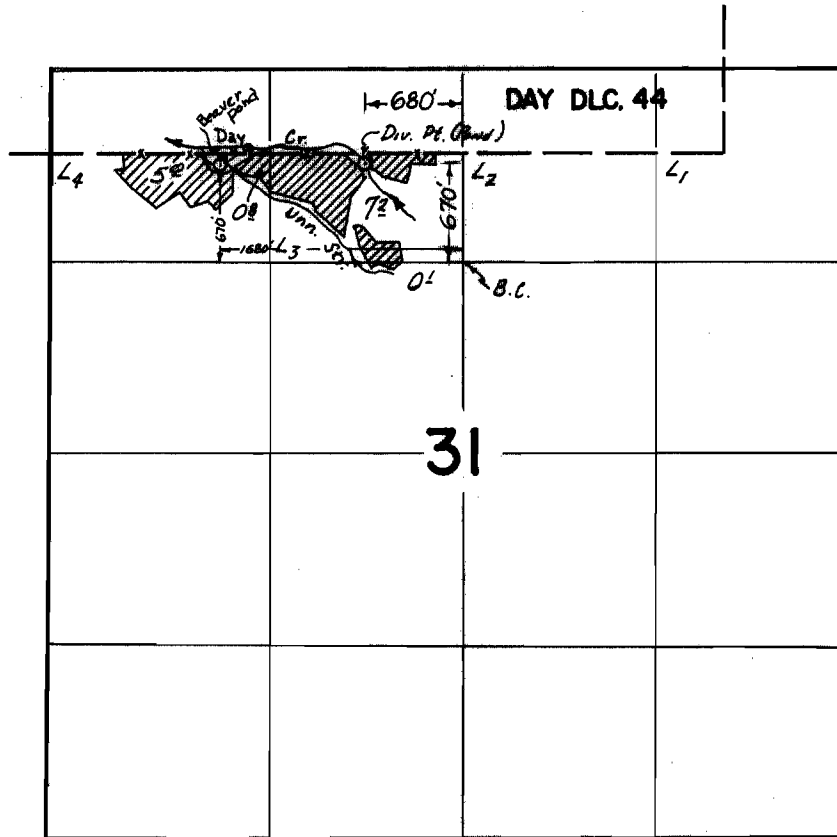

FINAL PROOF SURVEY
UNDER

Application No. 43756 Permit No. 32700
IN NAME OF

JAMES ATTEBERRY

Surveyed 10 MAY 19 72 by D. NORBY