


T.32S., R.6W., W.M.

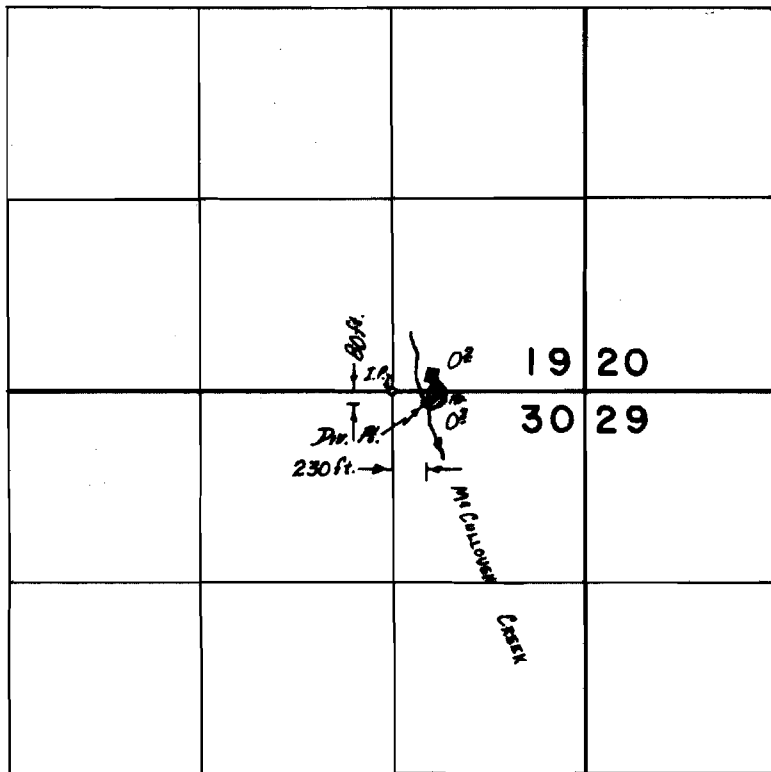

**FINAL PROOF SURVEY**  
UNDER

Application No. 46409 Permit No. 34676  
IN NAME OF

FRANK M. STEPHENS

Surveyed 23 Aug. 1972, by L.E. GOULD