


T. 5S., R. 3W., W.M.

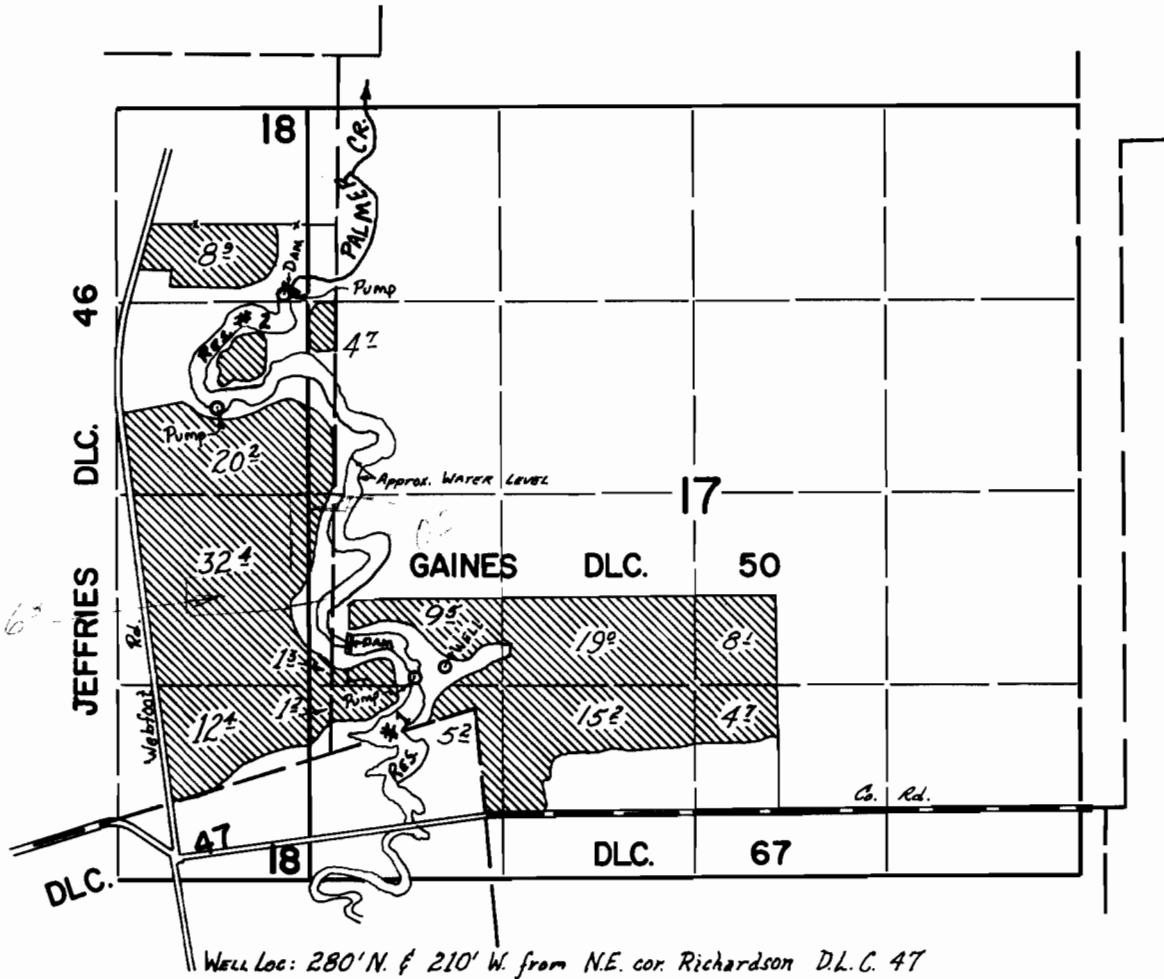

**FINAL PROOF SURVEY**  
UNDER

Application No. G-3604. Permit No. G-3391....  
IN NAME OF

X. J. DAUENHAUER

Surveyed Nov. 9 1972, by D. NORBY