


T.40S., R.8 & 9W., W.M.

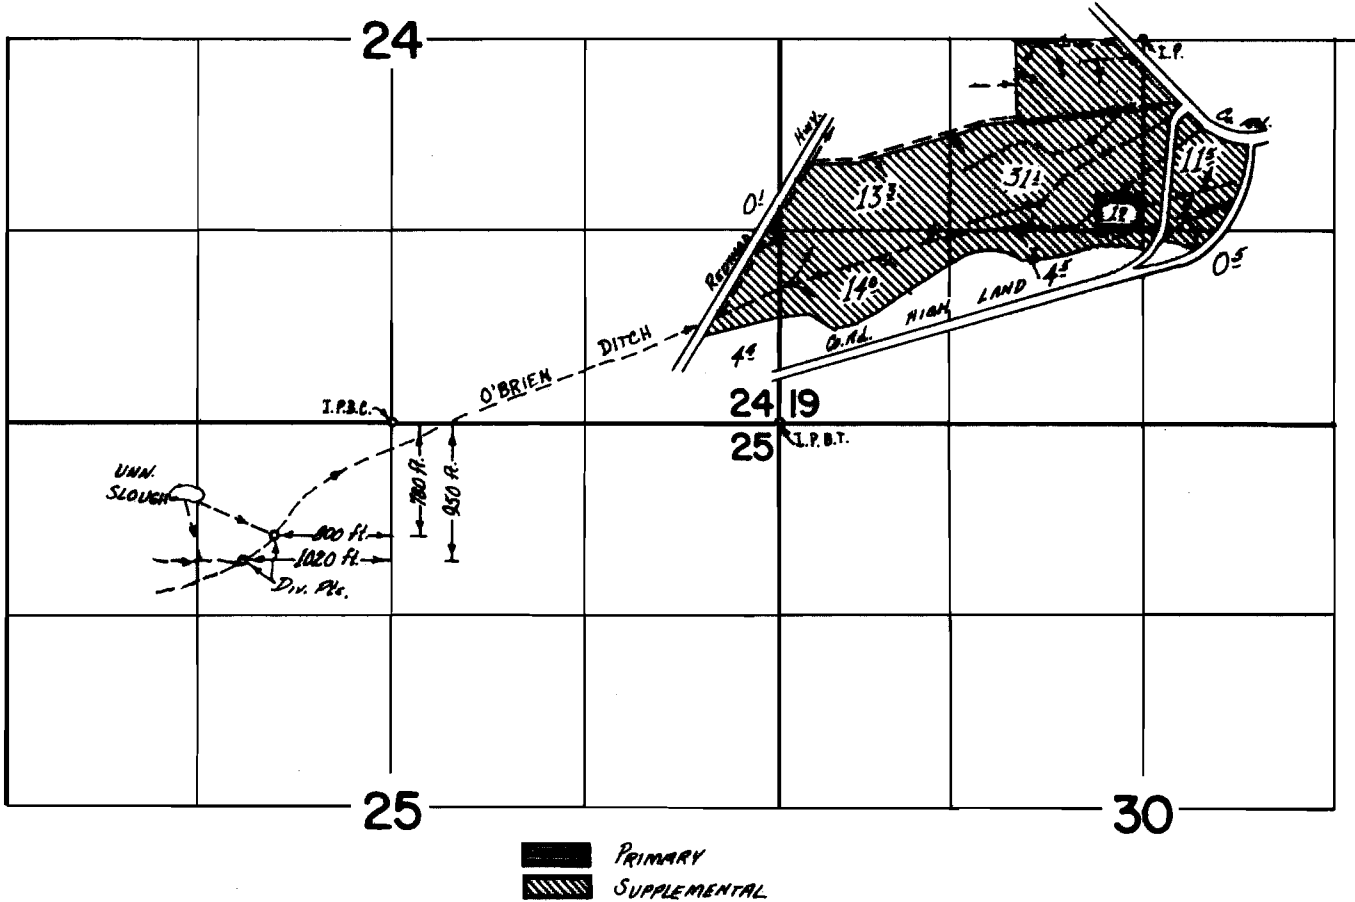

FINAL PROOF SURVEY
UNDER

Application No. 40860 Permit No. 30459
IN NAME OF

LOYD LEWIS

Surveyed 2 Nov. 1972, by L.E. GOULD