


T.39S. R.19E. W.M.

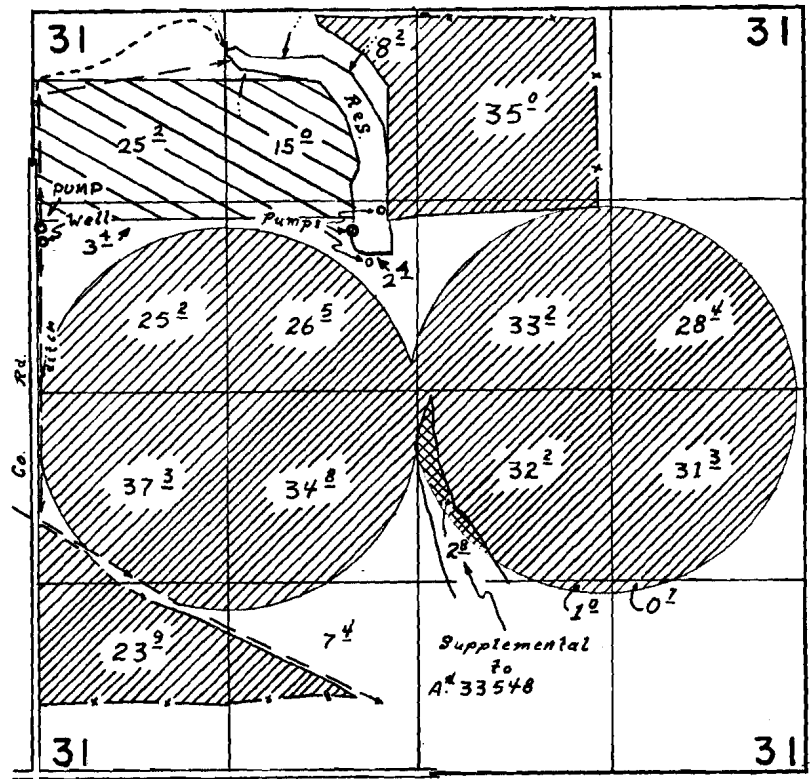

Co. Rd.
Well loc. 1607 S. & 40 E. from N.W. Cor. Sec. 31

Supplemental
Primary

FINAL PROOF SURVEY UNDER

G-5705 G-5514

Application No. G-5101 Permit No. G-4812
IN NAME OF

Clyde W. Fenimore

Surveyed 18 Sept. 1972, by L.E. Gould
Oct. 23, 1976 R.G. Mucken