


T. 39 & 40 S. R. 18 & 19 E. W.M.

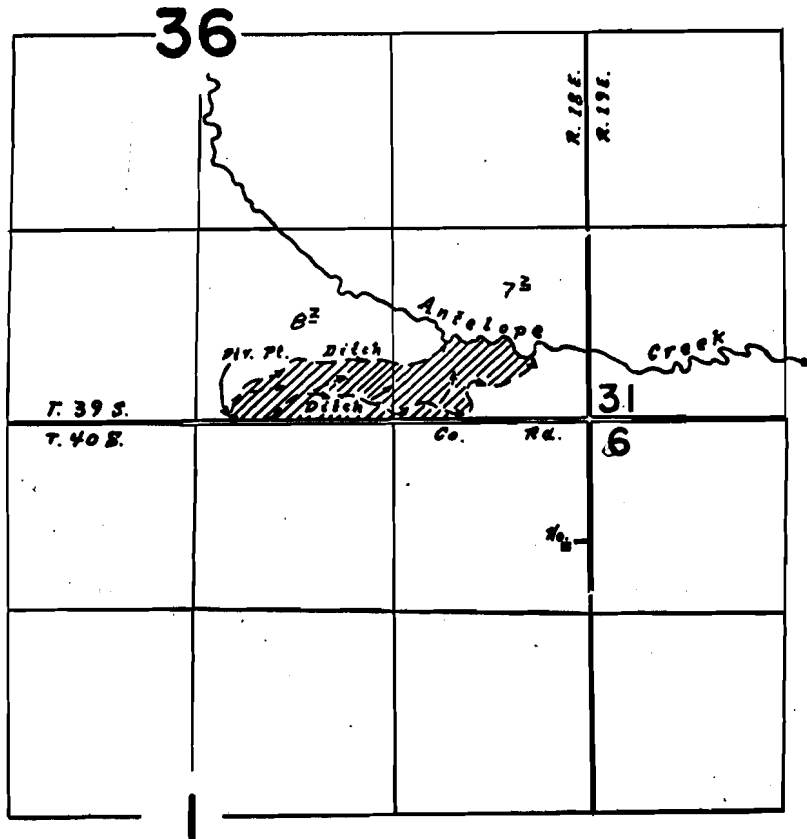

Div. Pt. Sec. 30' N. of 2430' W. from S.E. cor. Sec. 36

**FINAL PROOF SURVEY**  
UNDER

Application No. 43451 Permit No. 32503  
IN NAME OF

Everett H. & Roberta M. Shults

Surveyed 13 Sept. 1972, by L.E. Gould

39-184