


# T.9S.R.1W.W.M.

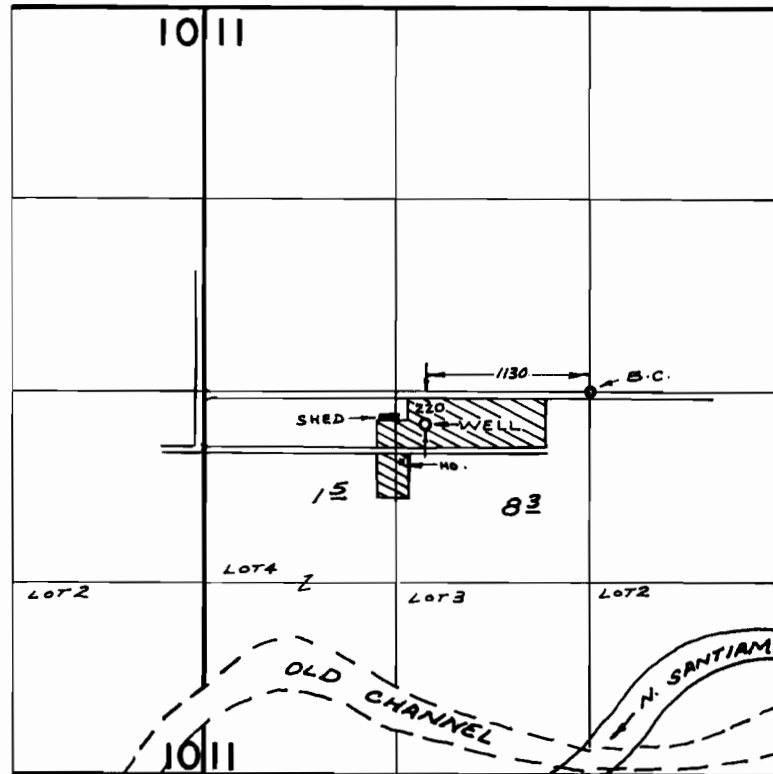

## FINAL PROOF SURVEY UNDER

Application No. G-3558 Permit No. G-3094  
IN NAME OF

RICHARD SCHOTTHOEFER

Surveyed OCT. 24, 1972, by R. MUGKEN