


T. 6S. R. 2W. W.M

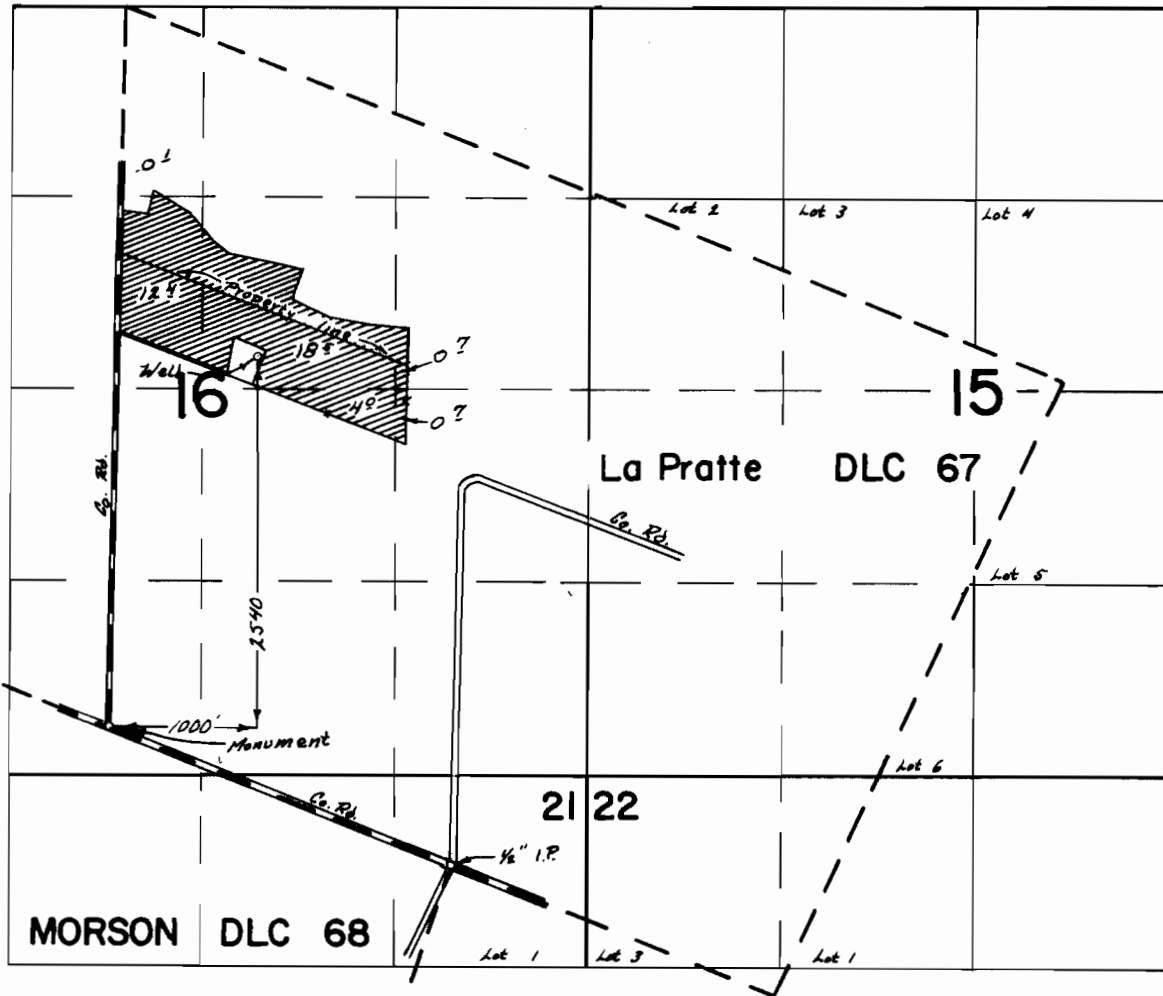

FINAL PROOF SURVEY UNDER

Application No. B-3946 Permit No. B-3703
IN NAME OF

DESSERT SEED CO. INC.

Surveyed May 17 1972, by R. G. Mucken