


T.4S., R.2W., W.M.

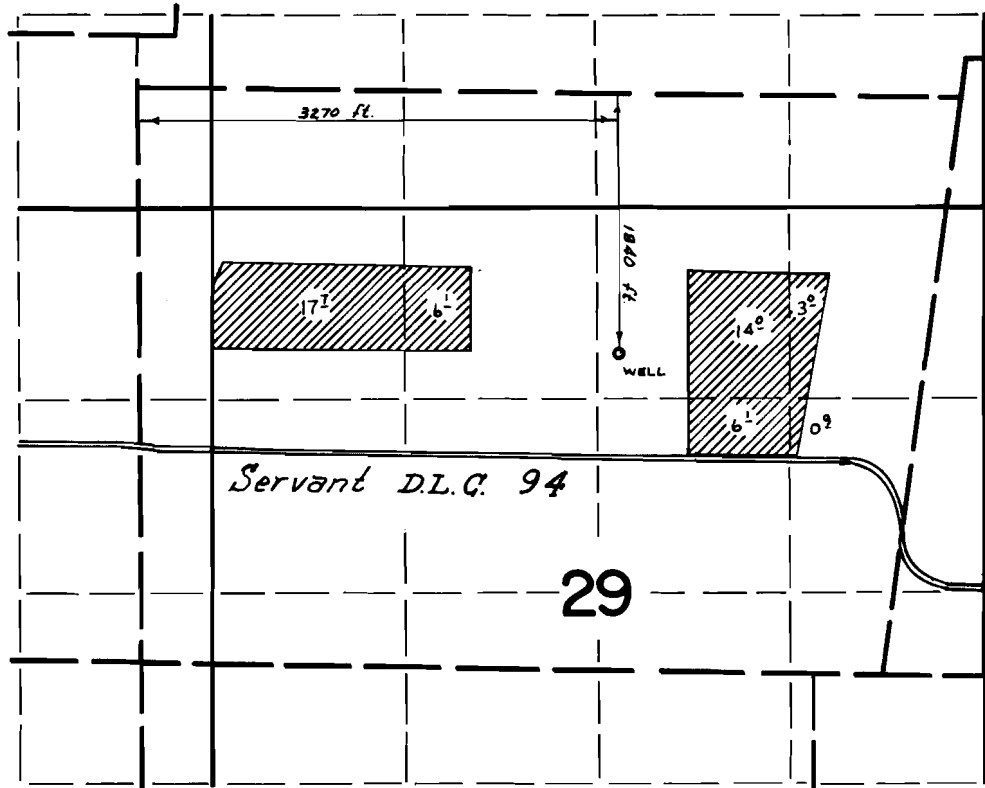

**FINAL PROOF SURVEY**  
UNDER

Application No. 6-4171 Permit No. G-3920  
IN NAME OF

EDWARD T. BRENTANO

Surveyed Oct. 4 1972, by D. Norby