


# T. 5 S., R. 2 W., W.M.

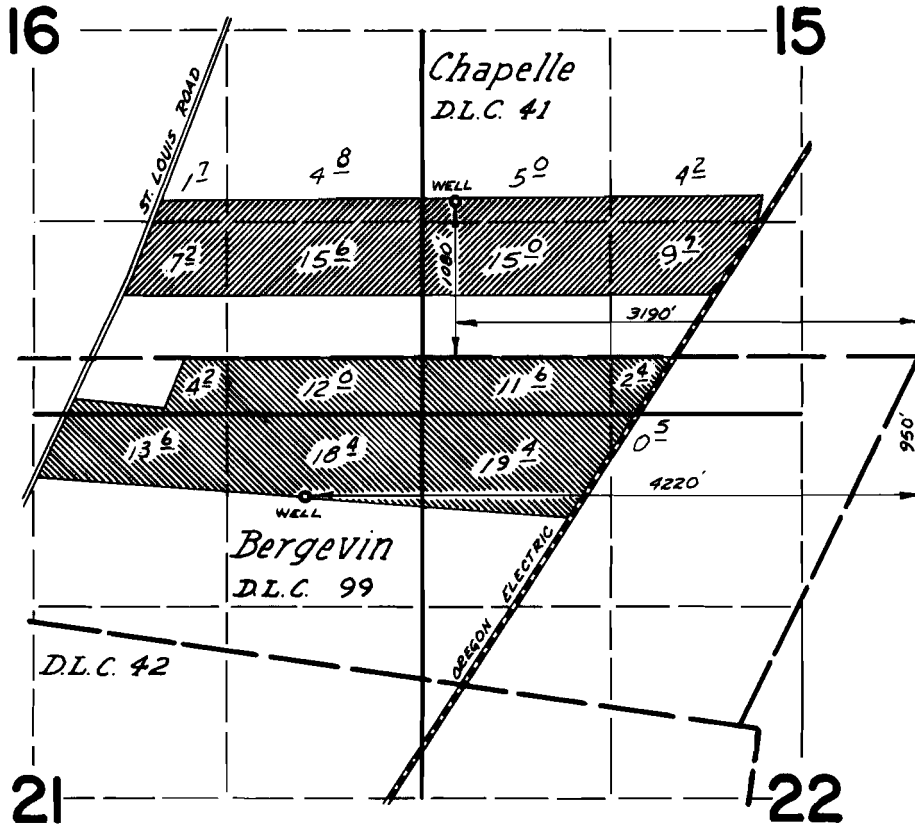

## FINAL PROOF SURVEY UNDER

Application No. G-4327 Permit No. G-3930  
G-4328 G-3931  
 IN NAME OF

EARL O. COOP

Surveyed Sept. 7, 1972, by L.F. Gould

