


T. 5 S., R. 2 W., W.M.

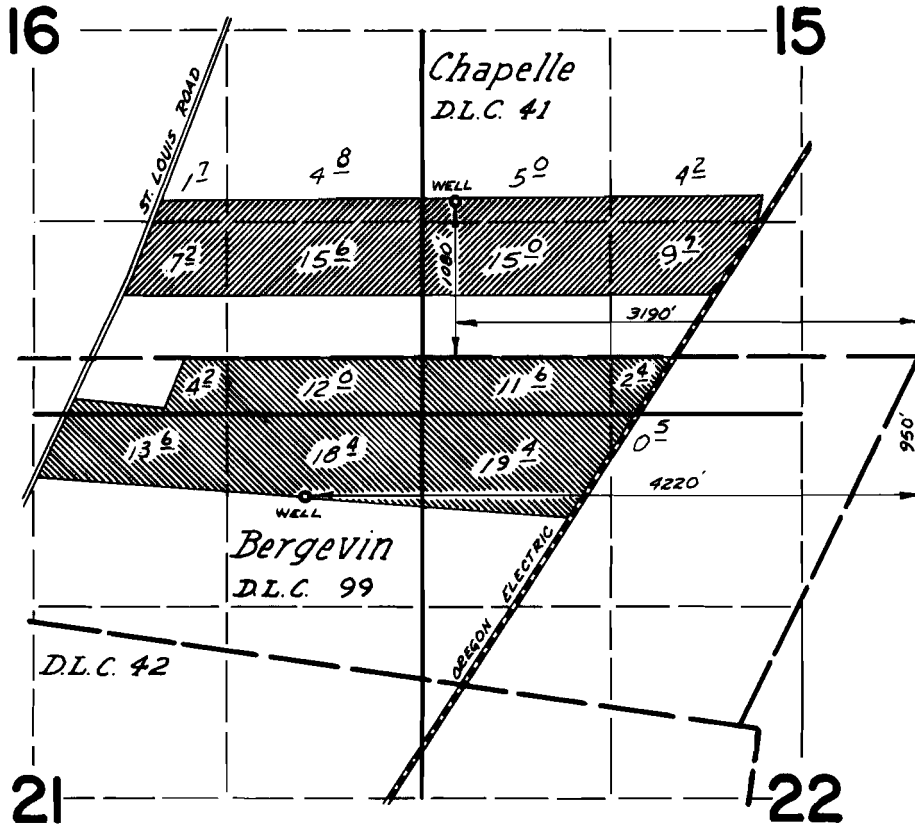

FINAL PROOF SURVEY UNDER

Application No. *G-4327* Permit No. *G-3930*
G-4328 *G-3931*
 IN NAME OF

EARL O. COOP

Surveyed *Sept. 7, 1972*, by *L.F. Gould*

