T.6S., R.1W., W.M.

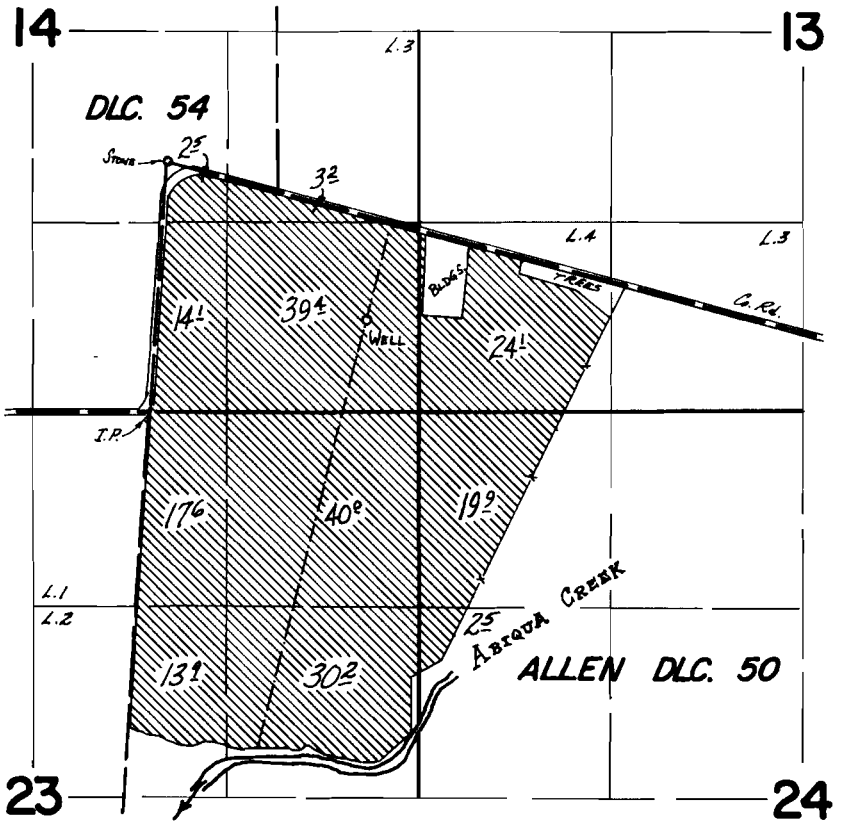

WELL loc.: 670'N. & 1490'E. from NE cor. lot 1, Sec. 23

FINAL PROOF SURVEY

UNDER

Application No. G-4196 Permit No. G-3961

IN NAME OF

AMMON BROS., INC.

Surveyed JUNE 15 19 72, by R. G. MUCKEN

DFN-3LL-178