


T.6S.R.2W.W.M.

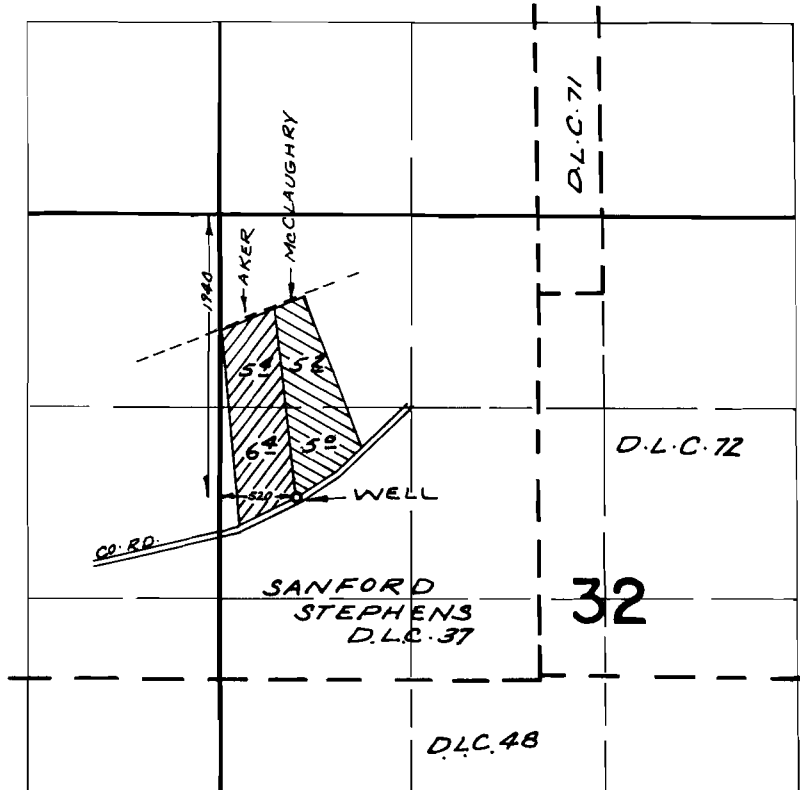

FINAL PROOF SURVEY UNDER

Application No. G-4216 Permit No. G-3980
IN NAME OF

ROY B. AKER & ELMER Mc CLAUGHRY

Surveyed MAY 15, 1972, by R. MUCKEN