


T.6S.R.3W.W.M.

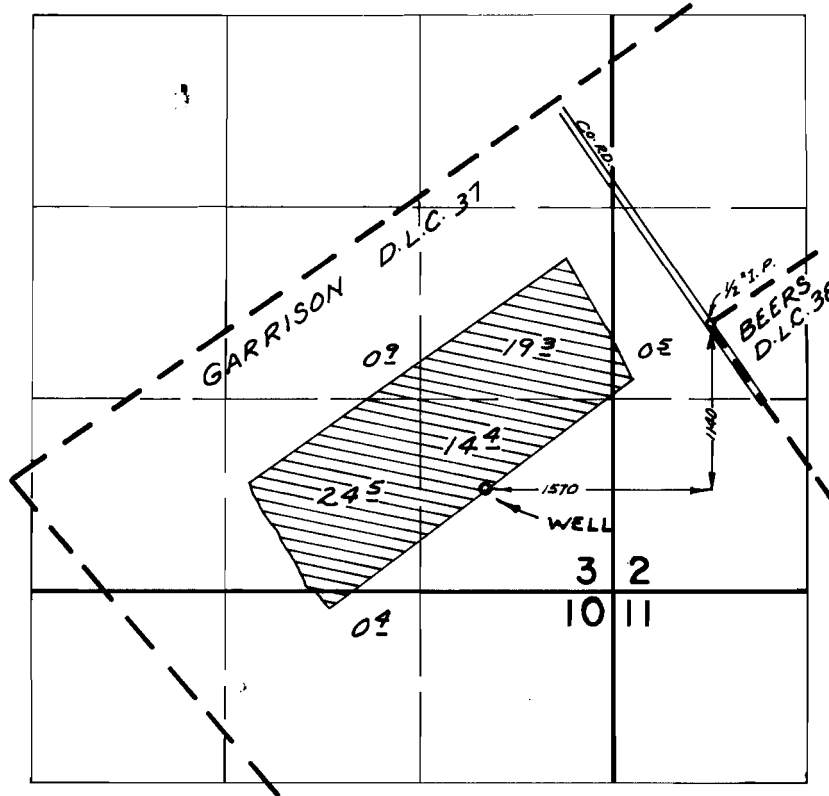

FINAL PROOF SURVEY UNDER

Application No. G-4263 Permit No. G-4015
IN NAME OF

PAUL TOWNSEND

Surveyed OCT. 2, 1972, by R. MURKIN