


T. 6S. R. 3W. W.M.

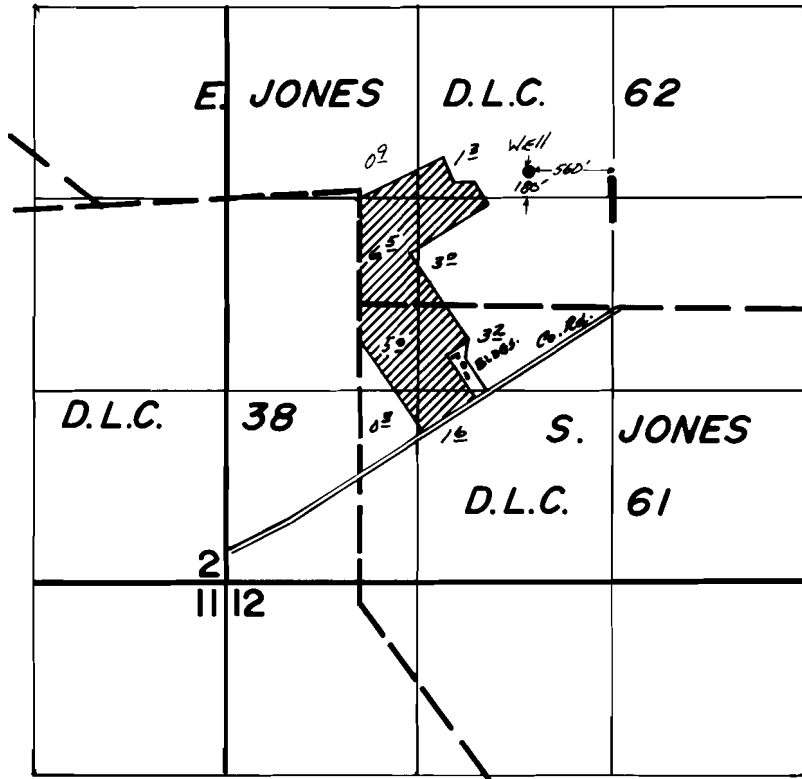

FINAL PROOF SURVEY UNDER

Application No. G-7777 Permit No. G-7373
IN NAME OF

.....PHILLIP H. GOULET.....

Surveyed Oct. 12, 1978, by J.S. Donaldson...