


T.6S. R.2W. W.M.

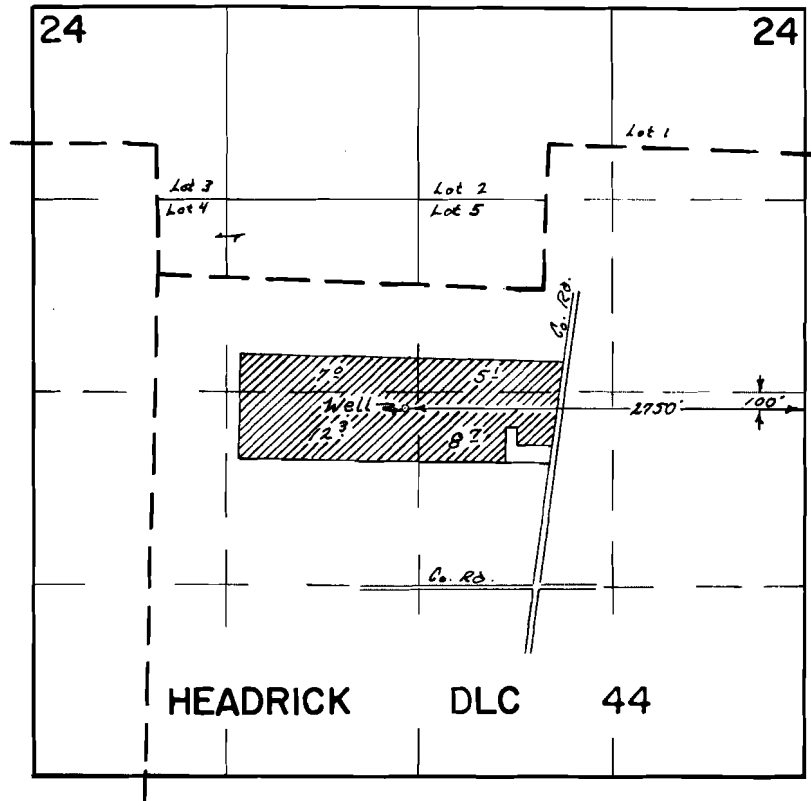

FINAL PROOF SURVEY
UNDER

Application No. G-4290 Permit No. G-4030
IN NAME OF

EDGAR SCHAAP

Surveyed May 18 1972, by R. B. Mucken