


T.6 S.R.2 W.W.M.

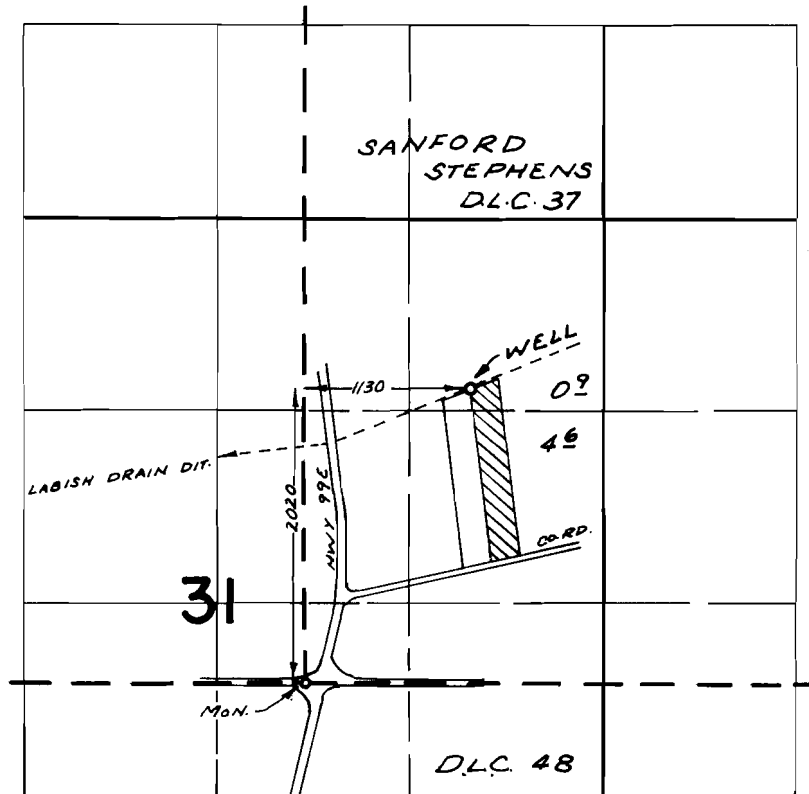

FINAL PROOF SURVEY UNDER

Application No. G-4303 Permit No. G-4064
IN NAME OF

ANTON PFAU, JR.

Surveyed APR. 4, 1972, by R. MUCKEN