


T. 68&7 S.R.2W.W.M.

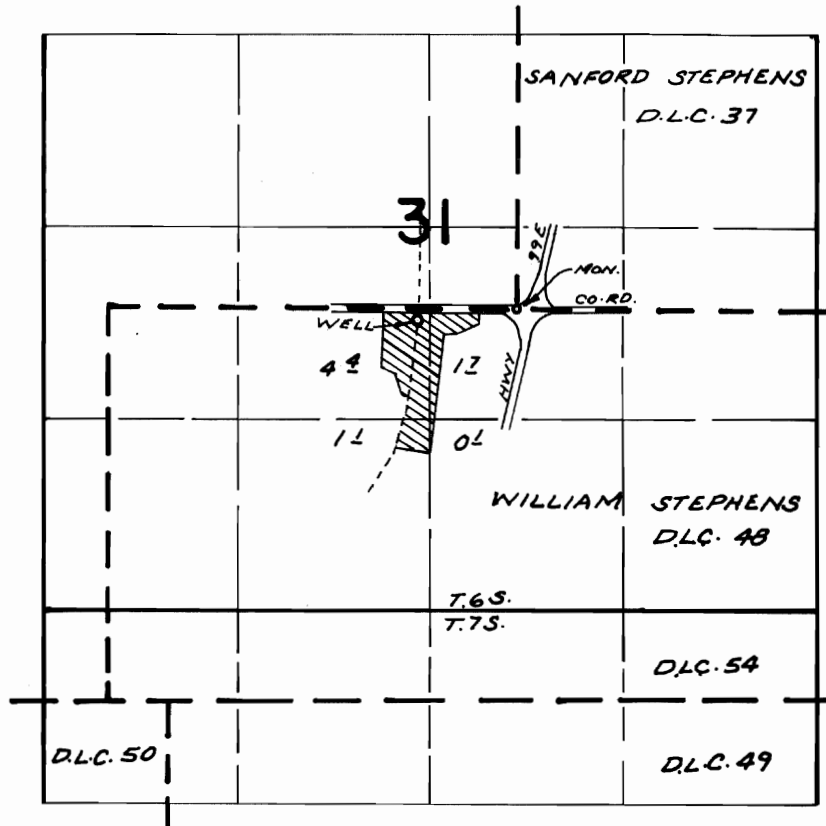

FINAL PROOF SURVEY UNDER

Application No. G-4314 Permit No. G-4072
IN NAME OF

CLETUS L. WOODS

Surveyed APR. 4, 1972, by R. MURKIN