


T.6S. R.1&2W. W.M.

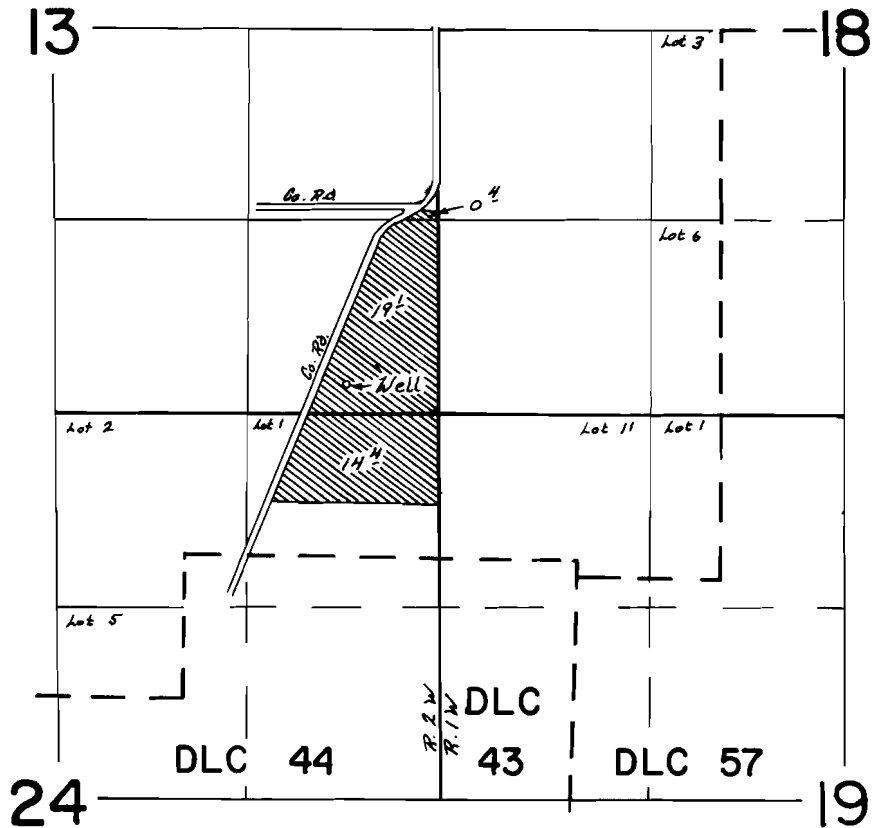

Well Loc: 200° N & 630' W From SE Cor Sec 13

FINAL PROOF SURVEY
UNDER

Application No. G-4318 Permit No. B-4076
IN NAME OF

HAROLD R. DUNN

Surveyed May 18 1972, by R. G. Mucken