


T.5S. R.1&2W. W.M.

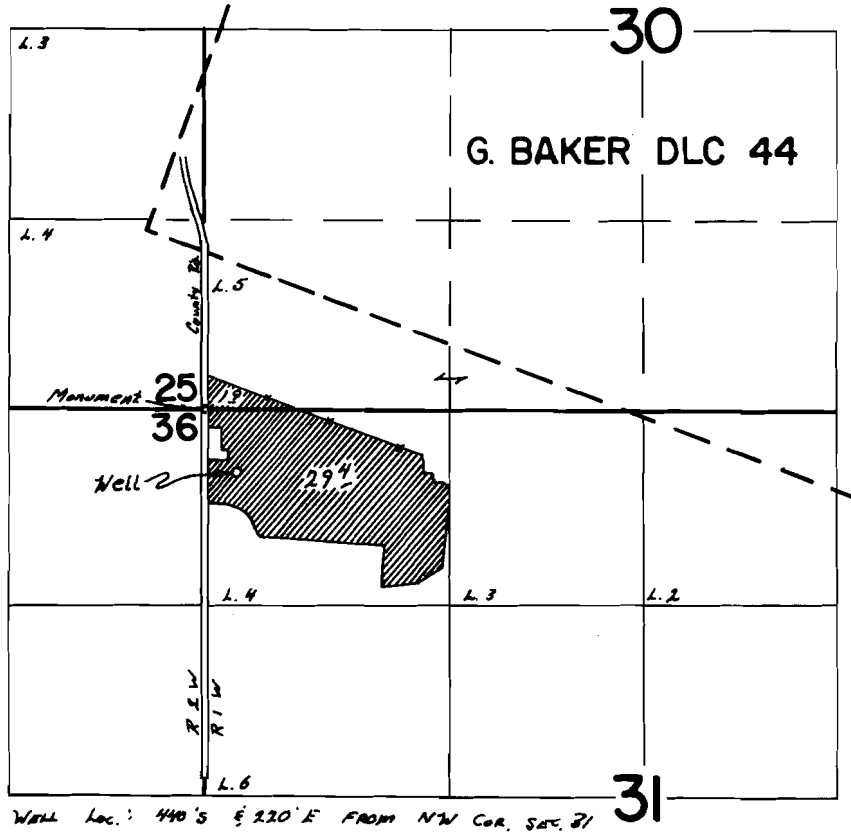

**FINAL PROOF SURVEY**  
UNDER

Application No. 6-4353 Permit No. 4-4108  
IN NAME OF

DONALD J. JUNGWIRTH

Surveyed Aug. 18 1972, by R. G. MUCKEN