


T.4S., R.2W., W.M.

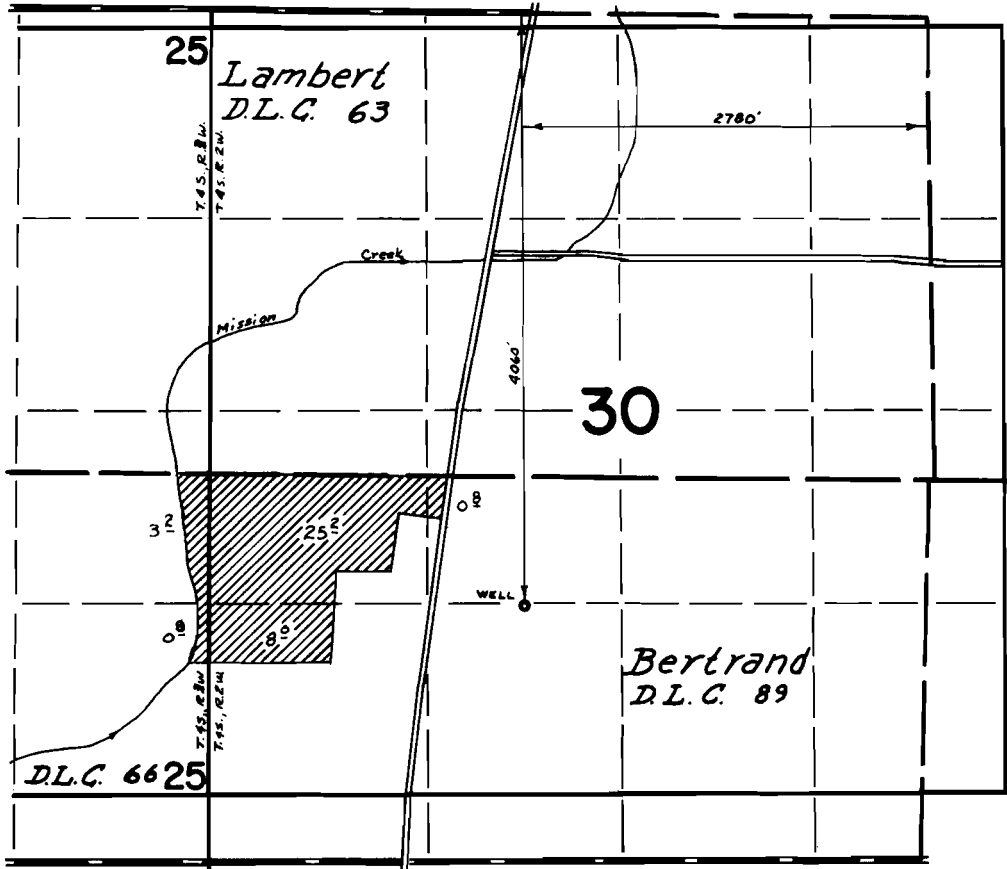

**FINAL PROOF SURVEY**  
UNDER

Transfer No. B-204  
Application No. G-4457 Permit No. G-4200  
IN NAME OF

CLAUDIO BUSTAMANTE

Surveyed Oct. 4 1972, by D. Norby