
T.6 S., R. I W., W.M.

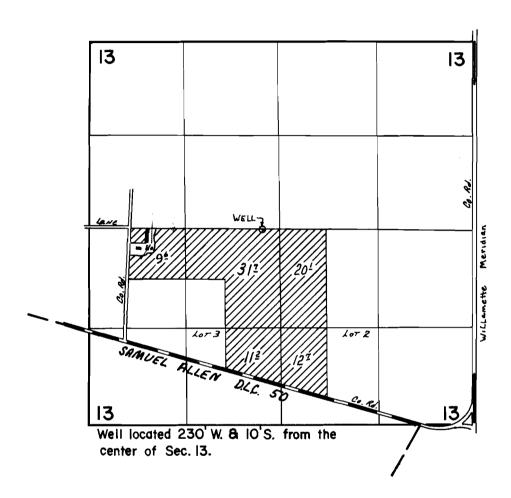

FINAL PROOF SURVEY

Application No. 6-4467 Permit No. 6-4210 IN NAME OF
ROBERT BUTSCH
Surveyed Oct. 13 19 72. by R. Mucken