


T. 6S. R. 2W. W.M.

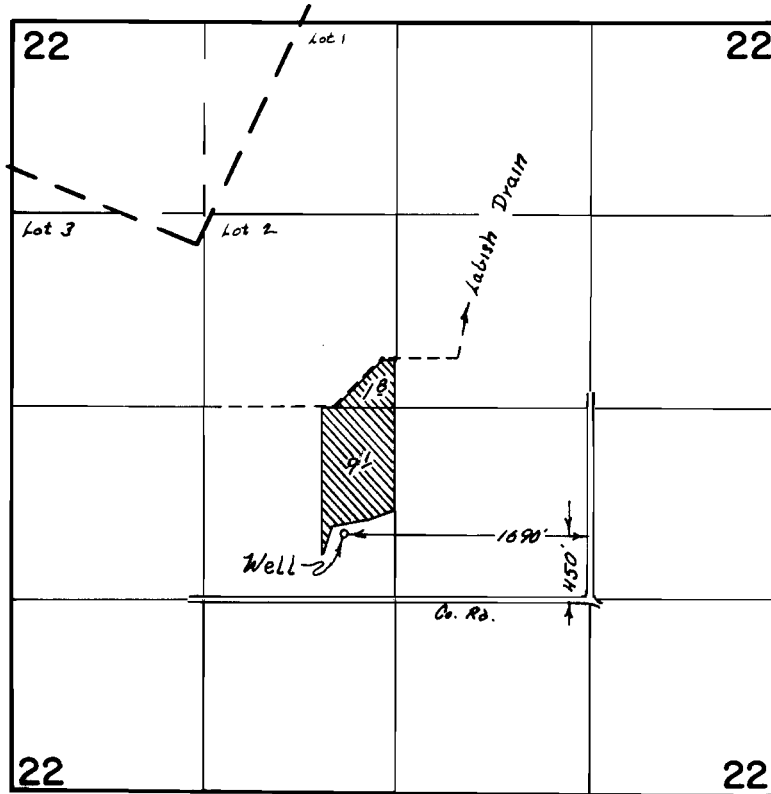

FINAL PROOF SURVEY
UNDER

Application No. B-4490 Permit No. B-4232
IN NAME OF

A. L. PUGH

Surveyed April 27 1972 by R. G. Mucken