


T.6S. R.2W. W.M.

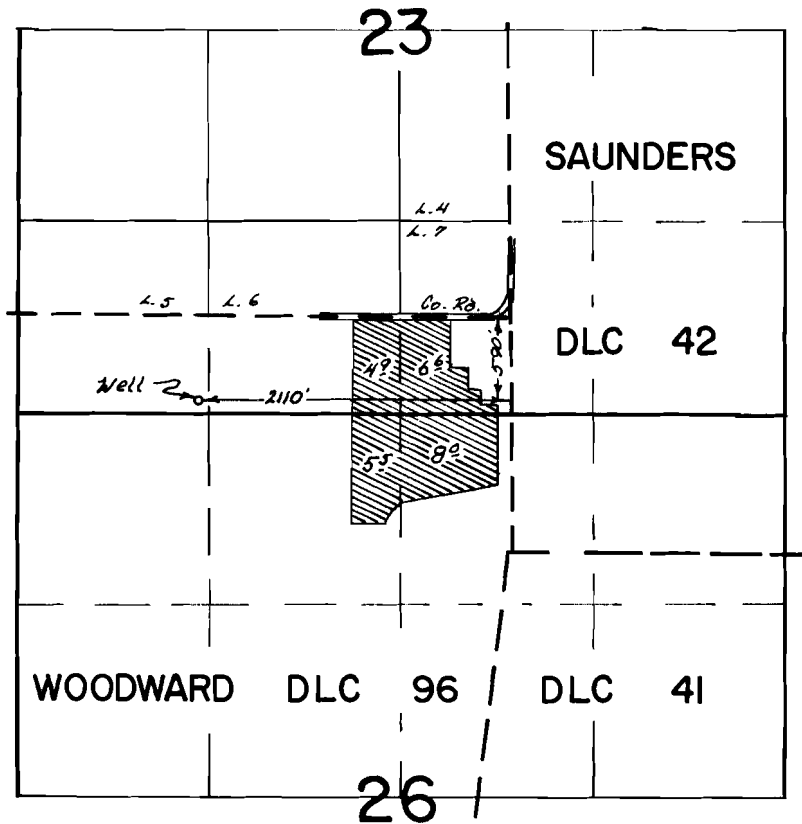

FINAL PROOF SURVEY
UNDER

Application No. B-4511 Permit No. A-4257
IN NAME OF

BRUCE L. DICKMAN

Surveyed May 16 1972, by R. G. Mucken