


T. 7 S. R. 2 W. W.M.

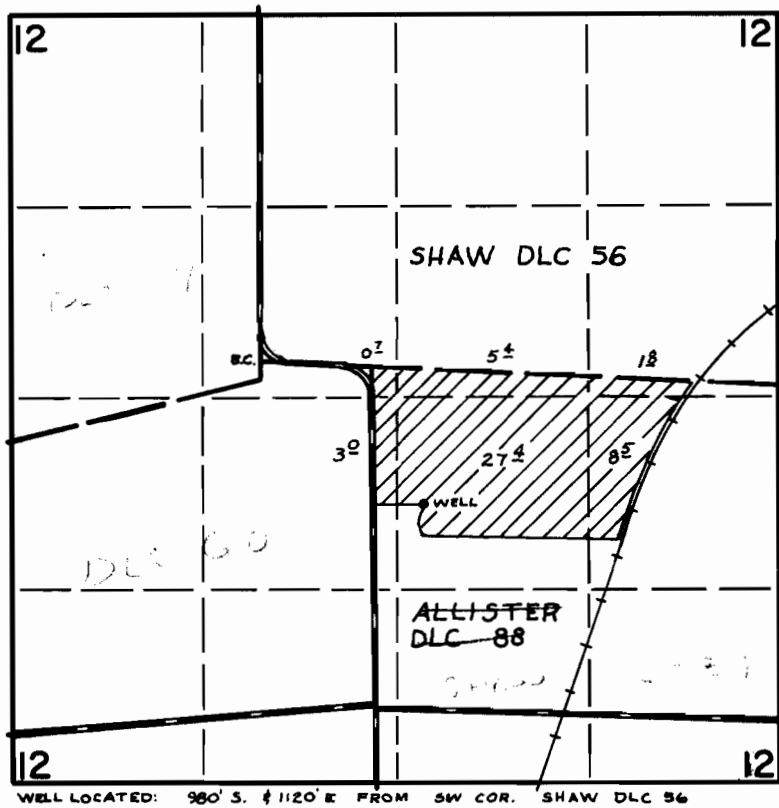

FINAL PROOF SURVEY UNDER

Application No. G-4732 Permit No. G-4452
IN NAME OF

CLARENCE SIMMONS, JR.

Surveyed APR. 27, 1972, by D. Norby