T. 7 S. R. 1 & 2 W. W. M.

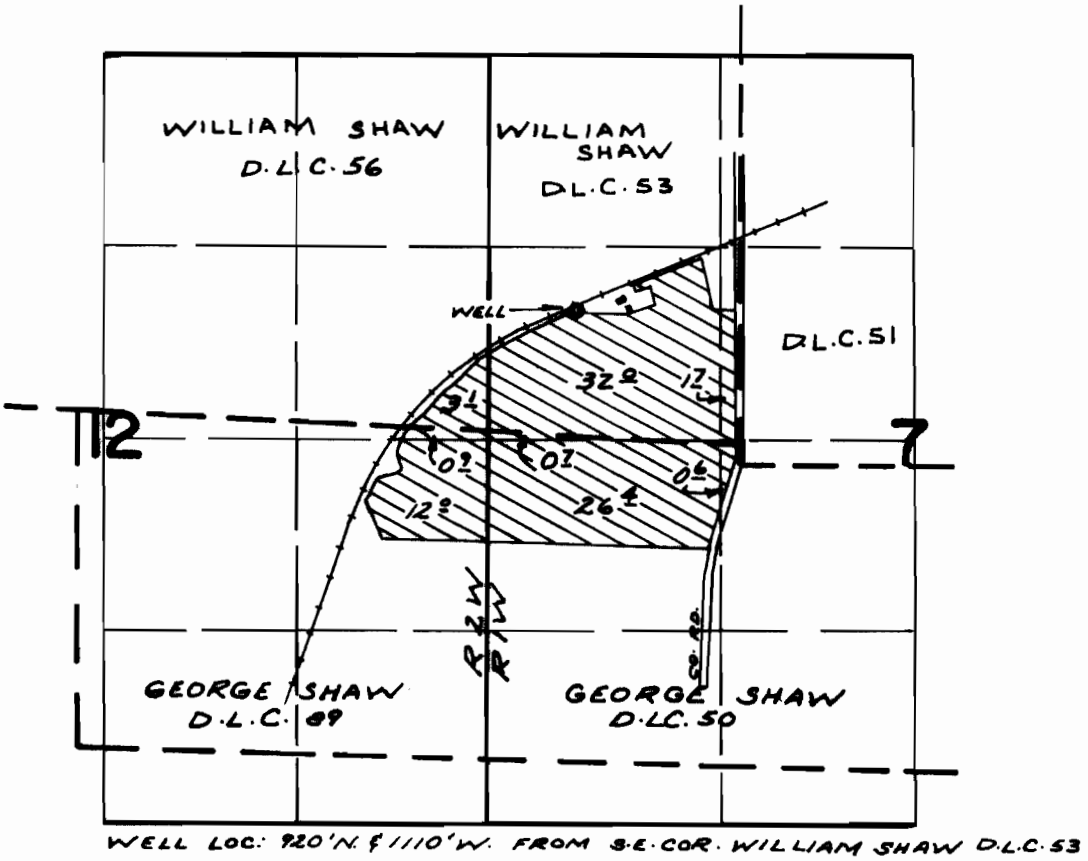

WELL LOC: 920'N. & 1110'W. FROM S.E. COR. WILLIAM SHAW D.L.C. 53

FINAL PROOF SURVEY
UNDER

Application No. G-4878 Permit No. G-4593
IN NAME OF

EMMA NEUSWANGER

Surveyed JUNE 16, 1972, by R. MUCKEN

DFN-20-113 & DFN-611-208