


T.5S. R.2W. W.M.

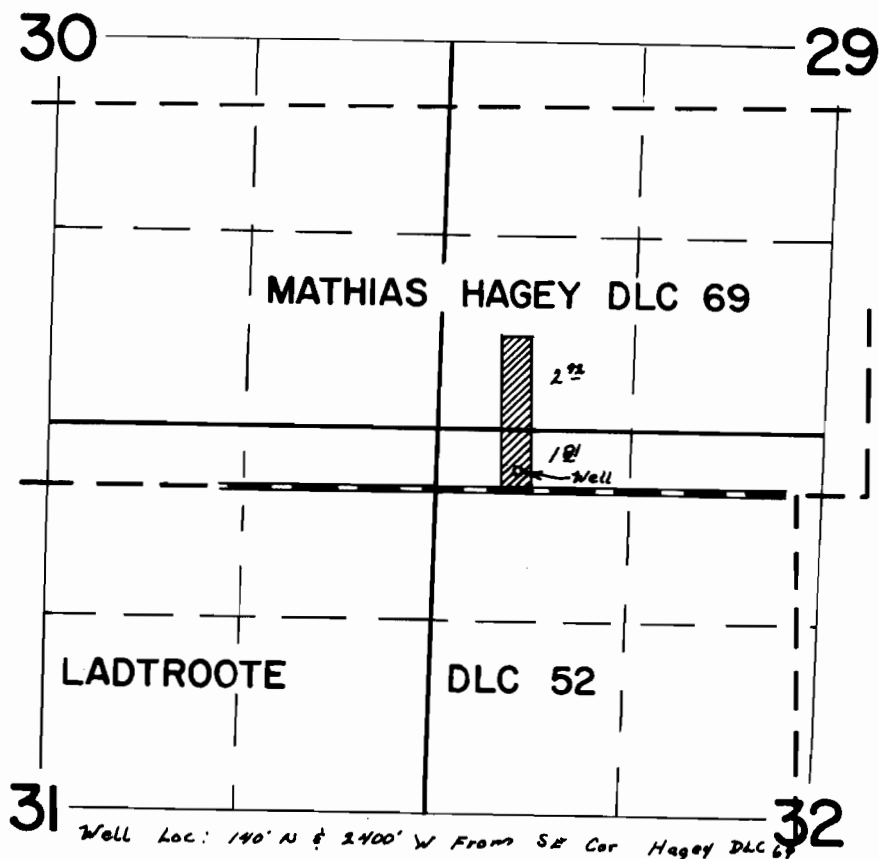

**FINAL PROOF SURVEY**  
UNDER

Application No. 6-1917 Permit No. 6-4674  
IN NAME OF

IRVING SEARS

Surveyed Aug. 15, 1972, by R. G. Mucken