


T. 7 S. R. 1 W. W. M.

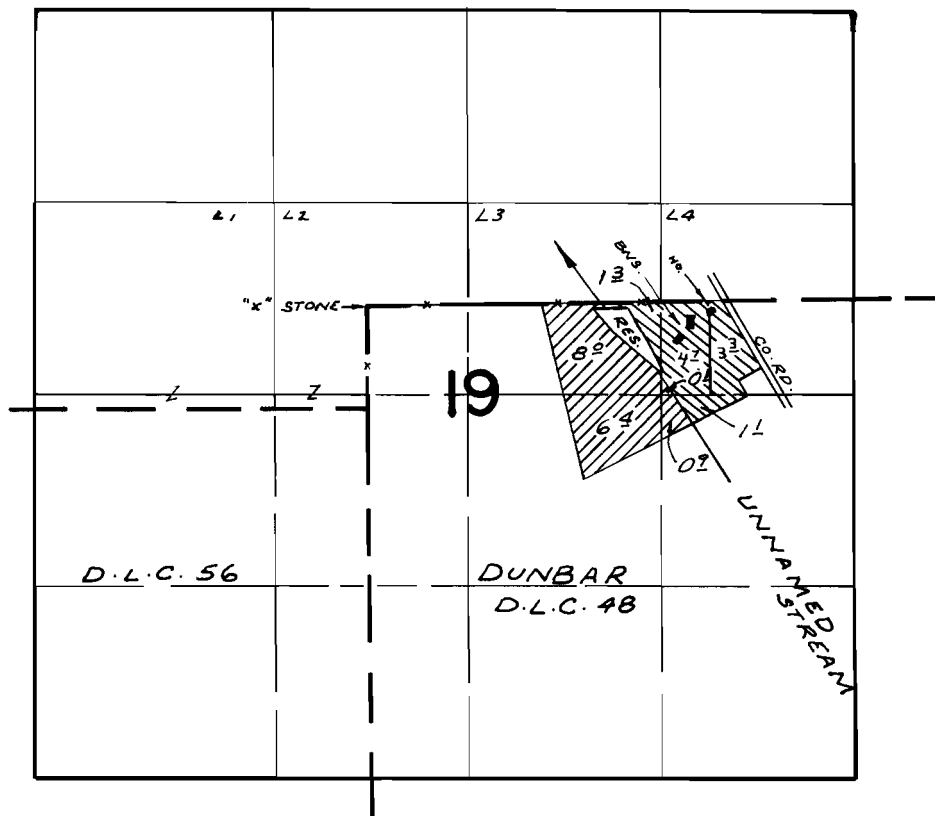

DIV. PT. LOC: 1630'E. & 30'S. FROM N.W. COR. DUNBAR D.L.C. 48

FINAL PROOF SURVEY

UNDER

51818
R-40209
40210

39024
R-4139
29819

Application No. 41472 Permit No. 30961
IN NAME OF

JAMES H. AND EUNICE V. THOMPSON

Surveyed MAY 31, 1972, by R. MAUGEN
OCT. 8, 1976 L. TOLL